



**City of Phoenix
Office of the City Engineer
Design and Construction Procurement**

**FIRE STATION 74
FD57100020**

ADDENDUM NO. 2

ISSUE DATE: August 13, 2024

Bidders are hereby notified that the Bidding and Contract Documents for the above project, for which Bids are to be received on August 20, 2024, are amended as follows:

Q1.	On sheet E1.1 attached; the highlighted area says to provide (6) additional 2" conduit from meet me box to cad rm. I am not sure where the CAD rm is located. I believe the Meet Me RM is the IT/ TEL RM? Also note 25. I do not see the existing fiber hand hole on the Civil drawings.
A1.	Communication box formerly on the east side of the building will now be located as shown on the south side of the building. There will no longer be a push button switch to control future traffic controls. Coordinate with civil drawings and communications companies for exact requirements prior to rough in. The Reference to CAD Room should have been referenced to IT/Tel Room No. 137. See attached updated Electrical Sheet E3.1 & E3.2
Q2.	What is the location of second compressor- SC1 (comment 36), other than S.C.B.A. compressor? Refer comment No. 36 on Electrical Drawing E 3.1? We are unable to locate Compressor # 2 location, since there are 2 compressors identified in comment 36 on E3.1.
A2.	Compressor AC-1 has been deleted from this project. Refer to sheet E5.1, please do not include anything associated with compressor AC-1. (disconnect switch in distribution, feeder, disconnect at compressor, etc.) SCBA compressor shall be connected per drawings.
Q3.	Is the generator to be provided by electrical contractor?
A3.	Yes
Q4.	Drawing E5.1, the question related to feeder braker to Panel A. Panel A schedule does not show feeder to Panel B, whereas Drawing 5.1 shows feeder to Panel B from Panel A. Please clarify whether Panel A will be 200A or 400A feeder disconnect, since Panel A is feeding Panel B?
A4.	Per One-Line Diagram, provide 200A switch/fuse, 200A feeder to panel 'A'.
Q5.	Panel schedule 5.2 (drawing 5.2) does not show Panel B fed from Panel A?
A5.	Per note in panel schedule 'A', provide double lugs to feed panel 'B'.
Q6.	Feeder between A to B is missing on Panel Schedule? Is there any other breaker needed?
A6.	There is no breaker required when connecting via double lugs.
Q7.	Water Service Connection to be installed by City Forces upon payment of prevailing permit fee per reference note 18 on CWS2.1. What is the cost of the Prevailing Permit Fee?
A7.	City will pay Permit Fees, Supply and Install Meter(s)
Q8.	Per sheet E1.1 note 8 the general contractor is supposed to figure 600LF per run of conduit for primaries. Please specify the location of the utility connection and the number/size of conduits that the general contractor should carry in this allowance. This is extremely important information as it relates to hard dig soil conditions
A8.	See attached. SRP Utility Plans are to be included in the scope of work pricing and to be included in the base bid.

Q9.	Confirm Access Control scope of work shown on A10.01 will be handled by City of Phoenix and bidding General Contractors only need to include conduit stubs and backboxes.
A9.	Yes, there is no access control equipment or wiring in the scope of work, but Electrical to provide raceways and back boxes for future install of system
Q10.	COW2.1 and COW2.2 calls for "work provided for this bid item, the offsite water extension from STA 3+17 to STA 6+67, is to be provided as a line-item unit cost by the contractor, as the costs associated with this is to be tracked due to different funding sources." Are the costs associated with the offsite water extension from STA 3+17 to STA 6+67 to be included in our Base Bid? If not, how do we provide "line-item unit cost" as the Bid Form in current form does not make reference to this.
A10.	See Addendum No. 1
Q11.	Updated specification 01 21 00 "Allowances" reads, "The markups or additional costs associated with these allowances shall be included in the base fee." Please confirm that the total values of the allowances AND the additional costs of markups should both be included in the base bid for the project.
A11.	The allowance is the exact cost provided in Addendum No. 1 and per Specification Section 01 21 00 for material. The General Contractor fees should be a part of the base bid.
Q12.	Updated specification 01 21 00 "Allowances" calls for an additional allowance #6 (FFE) to be carried. Per the original specification received with the IFB, there were only two allowances we should carry, Allowance #1 (unforeseen conditions) and Allowance #2 (appliances). Should the new allowance #6 (FFE) actually be titled "Allowance #3," or are there additional allowances #3 #4 and #5 that we are unaware of?
A12.	The only 3 allowances we have are #1, #2 and #6, The other 3 were deleted and/or combined with other items prior to bid.
Q13.	Having difficulty understanding A47 from Addendum 1. Please clarify if Removal Notes 1, 2, 3, 5, 6, 7, 8, 9, 13, and 14 on C2.1 shall be included in our Base Bid.
A13.	They were removal notes on the Fire Station Sheet C2.1sheet. They are for reference only and not a part of this project. All work related to the trailhead relocation is complete under separate contract.
Q14.	Follow up to A49 from Addendum 1: It's difficult for each GC bidder to provide pricing on relocation/adjustments of the existing utility boxes (Reference Note 32/C2.1) at the corner of 19th Ave/Chandler Blvd when we in the dark on the type of utility this is, how many boxes, and where they are being moved to. Can an Allowance be provided for all GC bidders to carry?
A14.	No allowance, Assume the boxes will be left in the current locations but lowered or raise to final grade.
Q15.	Referencing A84 on Addendum 1, please confirm all Concrete Roof Tile locations are to have (2) layers of 1.5" rigid polyiso insulation and 1/2" Densdeck coverboard.
A15.	Yes correct
Q16.	Please confirm below deck batt insulation requirements under Concrete Roof Tile areas. Wall Sections 2 & 3/A9.01 and 5 & 6/A9.02 does show R-38 batt insulation under Concrete Roof Tile areas, but the remainder of the wall sections do not.
A16.	All interior spaces requiring insulation is to be R-38 Typical.
Q17.	Interior Elevation 28/A4.04 calls out (3) rectangular wall hung items as keynote 37, 14" fixed stainless-steel shelf. What is drawn does not match up with other keynote 37's shown on 29 and 31/A4.04. Please confirm the (3) keynote 37 callouts on 28/A4.04 are correctly called out.
A17.	Keynote 37 in this elevation should be Keynote 52 which references the 3 tankless water heaters.
Q18.	Reference A59 from Addendum 1, please confirm that the Gas run shown on CWS2.1 by Reference Note 16, appx 510 LF, is the extent of what we need to cover for trenching, backfill, and sleeving for SWG piping. The drawing appears to continue east on Chandler Blvd, but we do not have a continuation showing how much further we need to go down Chandler Blvd.

A18.	General Contractor to assume a total run of 800 Linear to cover for trenching, backfill, and sleeving for SWG piping
Q19.	We were notified that the Praline plus specified as CL-1 is obsolete and will not be available after December 2024. Please provide us with an alternative to include in our pricing.
A19.	This has been confirmed that the Paraline Plus System has been discontinued please replace with the following Spec: USG PLANX UNIVERSAL PROFILE: optional reveal w/ snaploc insert size: 6" wide finish: timbre, color to be selected from timbre standard offerings, acoustics: A062d perforation + acoustibond backer, black
Q20.	Finish schedule calls for clear epoxy at interior CMU walls A3.31 Addt'l Remarks #3. The specification book page lists J. System 209 that is a water repellent and anti-graffiti coating on interior CMU. Page 383 specification book lists santile 255 and 555 both do not come in clear. What is the correct clear epoxy for interior CMU walls at apparatus bay and other areas listed on A3.31?
A20.	Please use Water Repellents per specification section 07 19 00
Q21.	As part of the bid submission check list provided by the city of phoenix, bid form E.O.C-1 should be completed and included with the final bid submission. It does not appear that form E.O.C-1 is included in the IFB. Please advise.
A21.	Bid form E.O.C-1 is NOT required
Q22.	As part of the bid submission check list provided by the city of phoenix, bid form P-3 should be completed and included with the final bid submission. It does not appear that form P-3 is included in the IFB. Please advise.
A22.	Bid form P-3 is NOT required
Q23.	The City of Phoenix typically requires that all Fire Alarms are Notifier. However, I do not see a specification section for the Fire Alarm requirements. Does this Fire Alarm system have to be Notifier?
A23.	Provide a fully addressable Onyx Works based fire alarm system, with full smoke detector coverage in all rooms, halls, and storage areas. It shall have a manual fire box located at building exit and notification appliance's location shall be included in all areas, in compliance with NFPA and City of Phoenix Code requirements. The system shall be a Notifier Fire Alarm Panel & System with OnyxWorks capability. Fire alarm panel shall be equipped with Embedded Gateway card (#NFN-GW-EM-3), allowing communication to the City of Phoenix OnyxWorks system through IP connections. The IP connection (CAT-6 data) will be provided by the City of Phoenix.

Plan Sheets:

1. 23224 E1.1 Delta-2.pdf – Updated Electrical Site Plan Sheet
2. 23224 E1.2 Delta-2.pdf – Updated Electrical Site Plan Sheet
3. 24-07-24T3567105RL.pdf – SRP Design Drawings for General Use and Reference


Call For Bids:

BIDS WILL BE READ: TUESDAY, AUGUST 20, 2024, AT 2:00PM ON 6TH FLOOR, ROOM 6 WEST
PHOENIX CITY HALL 200 W. WASHINGTON STREET PHOENIX, AZ 85003-1611

*All times are local Phoenix time

NOTE: Bidders must acknowledge receipt of this Addendum by listing the number and date, where provided, on the PROPOSAL P-1.

END OF ADDENDUM

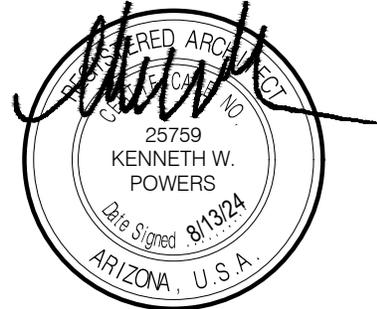

EXPIRES: 12-31-2024

CITY OF PHOENIX, ARIZONA
OFFICE OF THE CITY ENGINEER
DESIGN AND CONSTRUCTION PROCUREMENT



PROJECT SPECIFICATIONS AND CONTRACT DOCUMENTS

FIRE STATION 74
PROJECT NO. FD57100020

PROCUREPHX PRODUCT CATEGORY CODE 912000000
RFx 6000001606

AGREEMENT _____


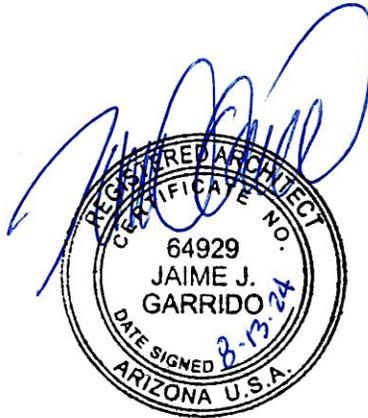


TABLE OF CONTENTS

PROJECT TITLE: FIRE STATION 74
PROJECT NO.: FD57100020



	<u>Page</u>
<u>SECTION I – Informative</u>	
(1) Call for Bids	C.F.B. - 1 to 2
(2) Information for Bidders	I.F.B. - 1 to 12
(3) Supplementary Conditions	S.C. - 1 to 19
(4) Environmental Clearance Letter	E.C.L. – 1
(5) Desert Tortoise / Burrowing Owl / Migratory Birds	3 Pages
(6) Storm Water Pollution Prevention Plan	S.W.P.P.P - 1 to 13
(7) APS Street Light Pole J-Box Detail	A.P.S. -1
<u>SECTION II - Submittals</u>	
(1) Bid Proposal	P. - 1 to P. - 2
(2) Proposal Submittal	P.S. - 1
(3) Surety Bond	S.B. - 1
(4) Small Business Enterprise Clause and Submittal Documents	SBE - 1 to 11
(5) Bidder's Statement of Proposed SBE Utilization	S.B.U. - 1
(6) Letter of Intent to Perform as a SBE Subcontractor/Supplier	L.O.I.-1
(7) Letter of Intent to Perform as a Subcontractor/Supplier Instructions & Worksheet	L.O.I.W-1
(8) List of Major Subcontractors and Suppliers	L.O.S. - 1
(9) List of All Subcontractors and Suppliers	L.O.S. - 2
(10) Bidder's Disclosure Statement	B.D.S.-1 to 4
(11) Affidavit of Identity	A.O.I. - 1
<u>SECTION III – Technical Specifications and Drawings</u>	
<u>Pages/Sheets</u>	
(1) Technical Specifications	719 Pages
(2) Plan Sheets	153 Sheets

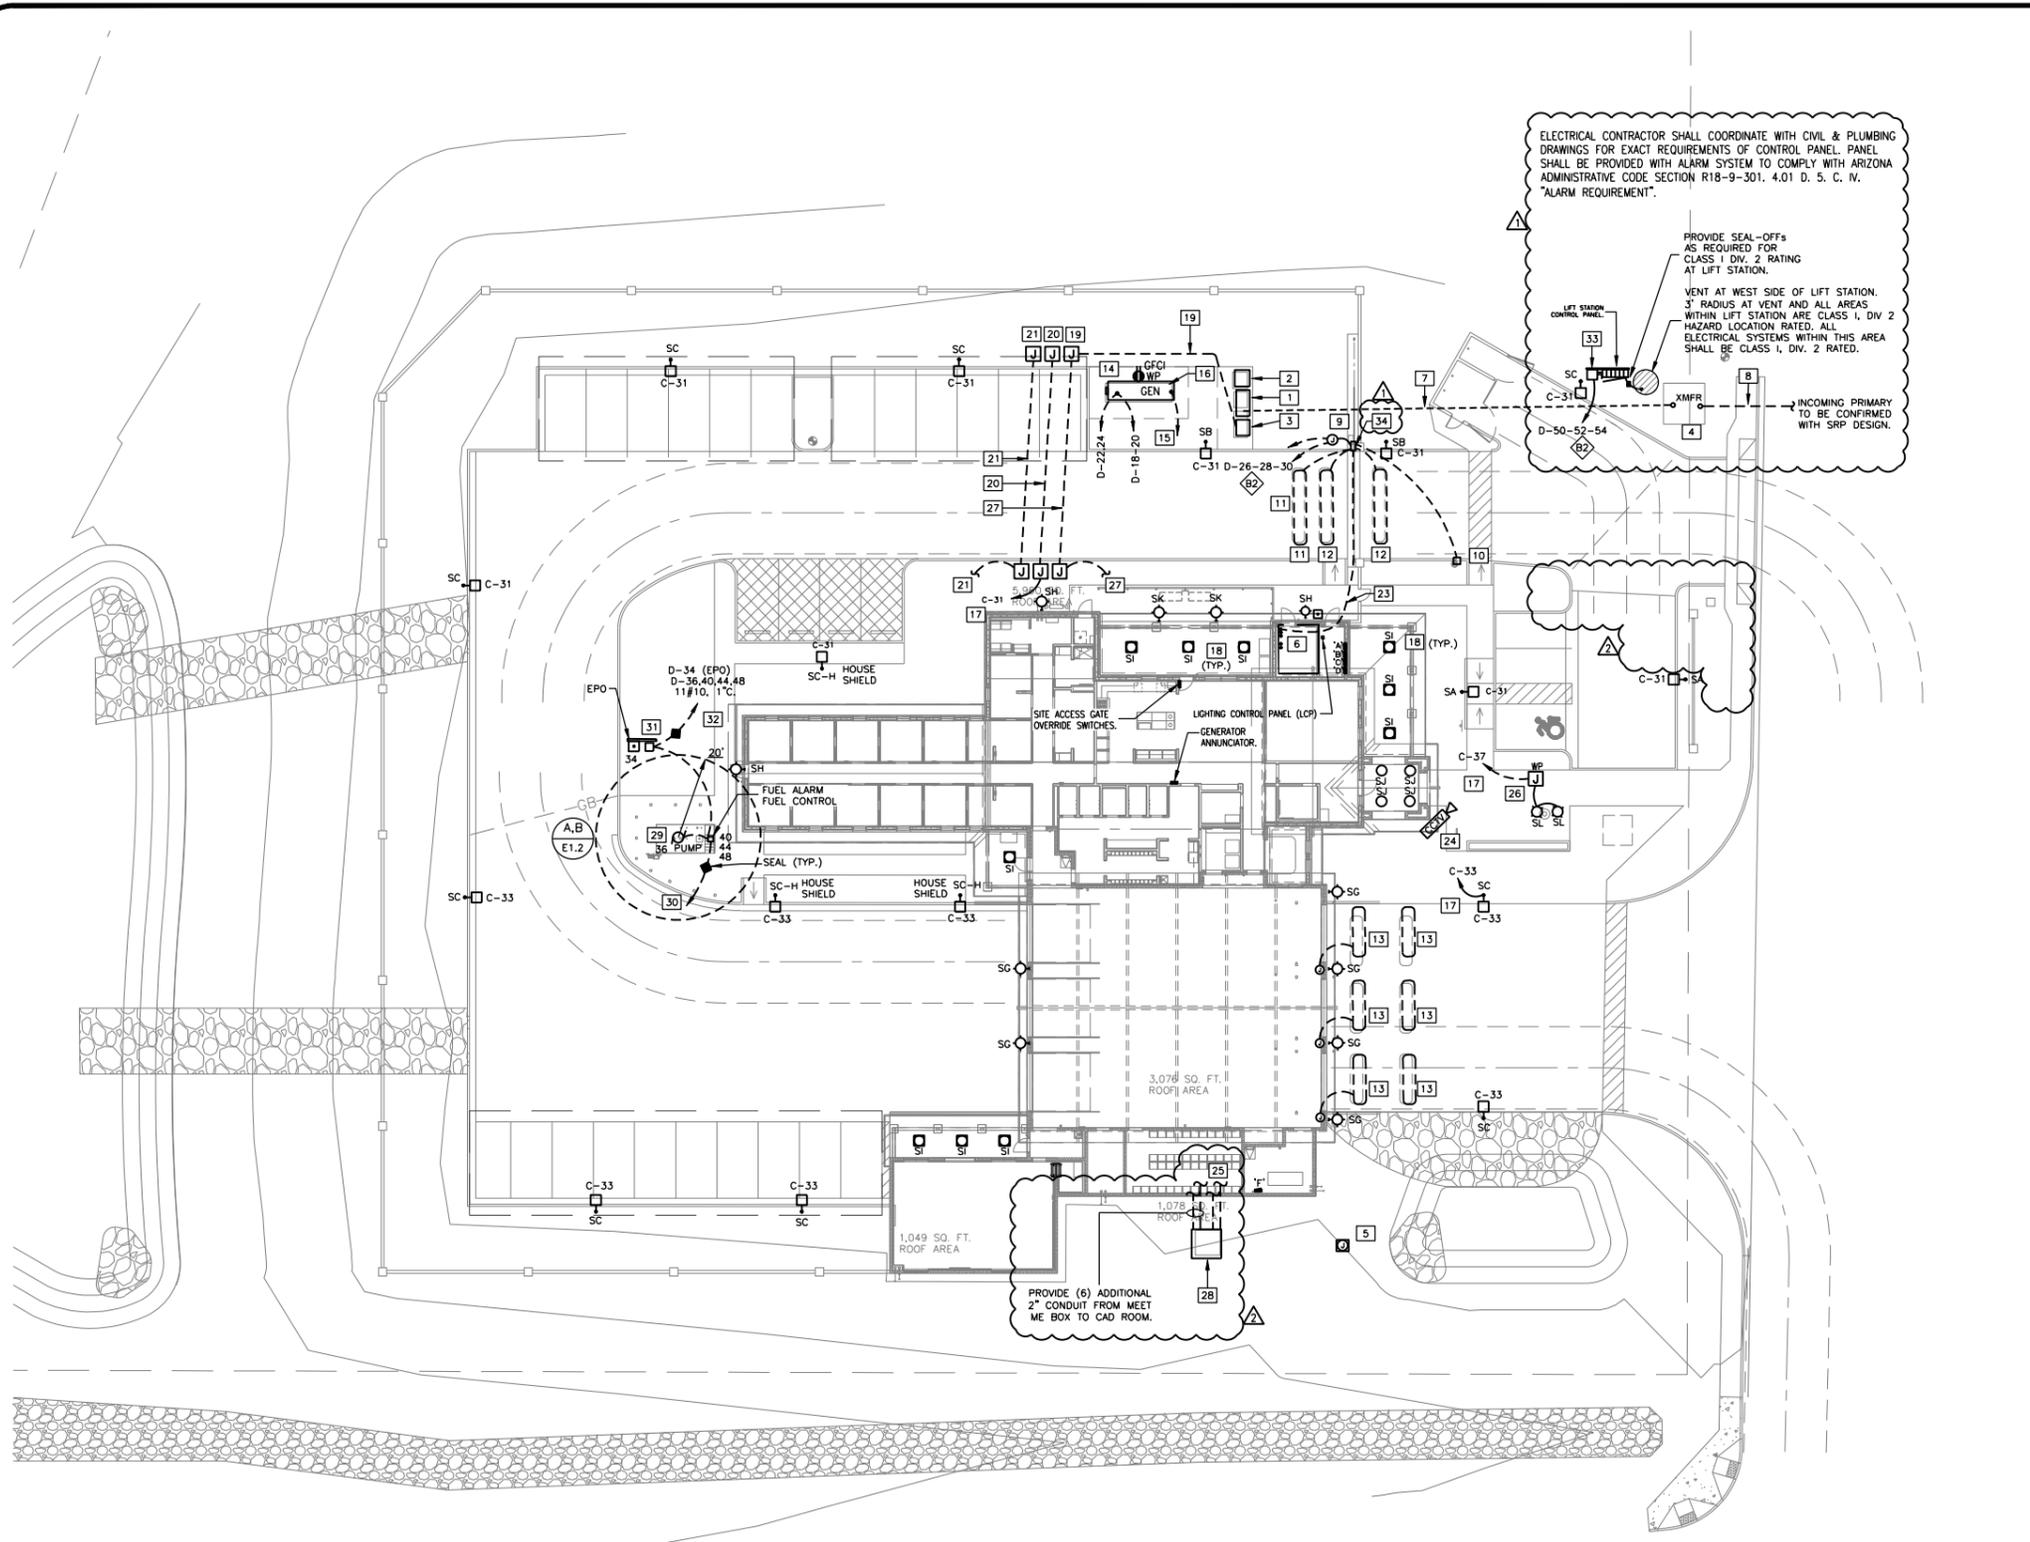

ELECTRICAL SITE PLAN
 SCALE: 1" = 20'-0"



- GENERAL NOTES**
- COORDINATE ALL SITE TRENCHING AND ROUTING OF CONDUITS WITH GENERAL CONTRACTOR/OWNER PRIOR TO COMMENCEMENT OF WORK TO AVOID EXISTING UNDERGROUND UTILITIES AND CONDITIONS.
 - PROVIDE #14 COPPER INSULATED TRACER WIRE SECURELY ATTACHED AT 8' ON CENTER OR WRAPPED AROUND NONMETALLIC CONDUITS AND LINES AND HAVE 12" OF WIRE EXPOSED ON ONE END PER BLUE STAKE LAW ARS 40-360.
 - PROVIDE COMPLETE MANDREL TESTING OF ALL UNDERGROUND CONDUITS AND PROVIDE 250 POUND TENSILE STRENGTH MULE TAPE WITH TRACER WIRE.
 - PROVIDE 48"-36" SWEEPS ON CONDUIT RUNS WITH NO MORE THAN TWO 90 DEGREE SWEEPS PER RUN.
 - ELECTRICAL CONTRACTOR SHALL BE RESPONSIBLE FOR CONTACTING THE REPRESENTATIVE UTILITY COMPANIES WITHIN (2) WEEKS OF AWARD OF CONTRACT AND SHALL FURNISH EACH REPRESENTATIVE (2) COMPLETE SETS OF CONSTRUCTION DOCUMENTS. VERIFY ALL TRENCH ROUTING, SERVICE LOCATIONS, ETC. WITH UTILITY COMPANY DESIGN CONSTRUCTION DRAWINGS AND SPECIFICATIONS PRIOR TO COMMENCING REQUIRED WORK.
 - SEE SHEET E0.1 FOR FEEDER SCHEDULE.
 - REFER TO SHEET E2.2 FOR LIGHTING FIXTURE SCHEDULE & IECC CALCULATIONS.

ELECTRICAL CONTRACTOR SHALL COORDINATE WITH CIVIL & PLUMBING DRAWINGS FOR EXACT REQUIREMENTS OF CONTROL PANEL. PANEL SHALL BE PROVIDED WITH ALARM SYSTEM TO COMPLY WITH ARIZONA ADMINISTRATIVE CODE SECTION R18-9-301, 4.01 D. 5. C. IV. "ALARM REQUIREMENT".


PROVIDE SEAL-OFFS AS REQUIRED FOR CLASS I DIV. 2 RATING AT LIFT STATION.

VENT AT WEST SIDE OF LIFT STATION. 3' RADIUS AT VENT AND ALL AREAS WITHIN LIFT STATION ARE CLASS I, DIV 2 HAZARDOUS LOCATION RATED. ALL ELECTRICAL SYSTEMS WITHIN THIS AREA SHALL BE CLASS I, DIV. 2 RATED.

INCOMING PRIMARY TO BE CONFIRMED WITH SRP DESIGN.

- KEY NOTES**
- SERVICE ENTRANCE SECTION ON CONCRETE PAD PER SRP REQUIREMENTS. REFER TO ONE LINE DIAGRAM ON SHEET E5.1. PRIOR TO CONSTRUCTION, OBTAIN APPROVAL OF LOCATION OF SES FROM POWER COMPANY. ARRANGE PULL SECTION IN ORDER TO ACHIEVE 25 FEET MINIMUM OF CONDUCTOR LENGTH BETWEEN POWER COMPANY SECONDARY AND LANDING LUGS IN PULL SECTION.
 - AUTOMATIC TRANSFER SWITCH. REFER TO ONE LINE DIAGRAM ON SHEET E5.1.
 - DISTRIBUTION SECTION DS-1. REFER TO ONE LINE DIAGRAM ON SHEET E5.1.
 - PROPOSED LOCATION OF UTILITY TRANSFORMER. PROVIDE TRANSFORMER PAD PER POWER COMPANY. FIELD VERIFY EXACT LOCATION WITH POWER COMPANY. PROVIDE PRIMARY CONDUITS FOR NEW POWER COMPANY TRANSFORMER. COORDINATE WITH CIVIL AND SRP.
 - PROVIDE (2) IN-GROUND, WP, PULL BOX AND 1" CONDUIT FOR POWER TO FUTURE LANDSCAPE LIGHTS. COORDINATE WITH LANDSCAPE & ARCHITECT PRIOR TO ROUGH IN.
 - APPROXIMATE LOCATION OF TELEPHONE, CABLE AND DATA EQUIPMENT MOUNTING BOARD. REFER TO SHEET E3.2 FOR ADDITIONAL INFORMATION. PROVIDE TWO 4" CONDUITS TO TELEPHONE COMPANY PEDESTAL. PROVIDE TWO 4" CONDUITS TO CABLE COMPANY POINT OF CONNECTION. COORDINATE WITH RESPECTIVE UTILITY COMPANY FOR POINTS OF CONNECTION. STUB UP CONDUITS 6" ABOVE FINISHED FLOOR IN IT/CAD ROOM.
 - SECONDARY CONDUITS FROM UTILITY TRANSFORMER TO BUILDING SES. SECONDARY CONDUITS TO BE BURIED 36" FROM FINISH GRADE. REFER TO ONE LINE DIAGRAM ON SHEET E5.1 FOR ADDITIONAL INFORMATION.
 - POWER COMPANY PRIMARY CONDUITS FROM UTILITY PRIMARY POINT OF CONNECTION TO UTILITY TRANSFORMER. PRIMARY CONDUITS TO BE BURIED. COORDINATE WITH SRP AS REQUIRED. ALLOW FOR 600' PER RUN.
 - GATE OPERATOR. PROVIDE IN-GRADE PULL-BOX AND CONNECTION TO SMART TOUCH CONTROL PANEL. DRIVE RAIL, TRAVEL STOPS, PHOTO EYES, SAFETY EDGE, LOOPS, KEYPAD, OPTICON PHOTO-SENSOR, LIMIT SWITCHES, ETC. AS REQUIRED. PROVIDE CONCRETE BASE PER MFR'S RECOMMENDATION. PROVIDE 1" CONDUIT AND CONNECTION TO OVERRIDE SWITCH IN DINING AREA. REFER TO SHEET E3.2.
 - GATE KEYPAD. PROVIDE 1" CONDUIT AND CONNECTION TO GATE OPERATOR PER MANUFACTURER'S RECOMMENDATIONS. REFER TO ARCHITECTURAL DRAWINGS FOR INSTALLATION AND ADDITIONAL DETAILS.
 - FREE EXIT LOOP #12 TWISTED STRANDED WIRE WITH DIRECT BURIAL JACKET.
 - OBSTRUCTION LOOP: #12 TWISTED STRANDED WIRE WITH DIRECT BURIAL JACKET.
 - OBSTRUCTION LOOP: #12 TWISTED STRANDED WIRE WITH DIRECT BURIAL JACKET IN 3/4" CONDUIT. REFER TO OVERHEAD DOOR WIRING DIAGRAM ON SHEET E5.3 FOR ADDITIONAL INFORMATION. COORDINATE FINAL LOCATION WITH PROJECT MANAGER.
 - PROVIDE CONNECTION TO GENERATOR JACKET HEATER, CHARGER AND RECEPTACLE.
 - PROVIDE 1" CONDUIT WITH PULL STRING AND ANNUNCIATOR CABLE TO GENERATOR ANNUNCIATOR PANEL AND PROVIDE CONDUIT BETWEEN GENERATORS. SEE SHEET E3.2.
 - ENGINE GENERATORS AND SOUND ATTENUATED WEATHERPROOF HOUSING. REFER TO ONE LINE DIAGRAM AND SPECIFICATIONS FOR ADDITIONAL INFORMATION.
 - ROUTE LIGHTING CIRCUIT VIA LIGHTING CONTRACTOR. REFER TO SHEET E1.3 FOR ADDITIONAL INFORMATION. CIRCUITING SHALL NOT VARY FROM THAT SHOWN ON PLAN WITHOUT APPROVAL FROM PROJECT COORDINATOR.
 - SEE SHEETS E2.1 & 2.2 FOR LIGHTING FIXTURE CIRCUIT(S).
 - PROVIDE 2" CONDUIT WITH PULL-STRING TO IN-GROUND J-BOX FOR POWER TO FUTURE PHOTO VOLTAC SYSTEM.
 - PROVIDE 2" CONDUIT WITH PULL-STRING TO IN-GROUND J-BOX FOR POWER TO FUTURE PARKING CANOPIES.
 - PROVIDE IN-GROUND PULL-BOX FOR FUTURE CONNECTION TO FUTURE EV CHARGING STATION. PROVIDE 1" CONDUIT WITH PULL STRING TO PANEL 'D'.
 - NOTE NOT USED.
 - PROVIDE (1) 2" CONDUIT WITH PULL-STRING TO IT/CAD ROOM FOR GATE OPERATOR COMMUNICATION. COORDINATE FINAL ROUGH-IN AT GATE OPERATOR AND IT/CAD ROOM WITH INSTALLER AND PROJECT MANAGER.
 - OWNER SECURITY CAMERA SHOWN FOR REFERENCE ONLY. REFER TO SHEET E4.1 FOR ADDITIONAL INFORMATION AND LAYOUTS.
 - PROVIDE (2) NEW 2" UNDERGROUND CONDUITS FROM EXISTING FIBER HANDHOLE TO IT/CAD ROOM. REFER TO CIVIL DRAWINGS FOR LOCATIONS.
 - PROVIDE IN-GROUND PULL BOX FOR CONNECTION TO FLAGPOLE LIGHTING FIXTURE. COORDINATE FINAL REQUIREMENTS WITH GENERAL CONTRACTOR AND FINAL SELECTED FLAG POLE AND ASSEMBLY.
 - PROVIDE ONE 1" EMPTY CONDUIT WITH NYLON PULL STRING FROM IN-GROUND J-BOX TO IT/CAD ROOM TO FUTURE P.V. SYSTEM MONITORING.
 - PROVIDE #9 PULL BOX. COORDINATE WITH CIVIL AND TRAFFIC CONTROL PLANS.
 - PROVIDE THREADED CONDUIT PER NEC 514.8. SEAL CONDUIT AT DISPENSER PER NEC 514.9. PROVIDE CONNECTION TO PUMP PER MANUFACTURER'S REQUIREMENTS. SEE TYPICAL CLASSIFICATION AND CLEARANCE DETAILS A AND B, SHEET E1.2 FOR ADDITIONAL INFORMATION.
 - PROVIDE (4) 1.5" CONDUITS WITH PULL-STRING TO IT/CAD ROOM FOR FUEL SYSTEM COMMUNICATION AND LEAK DETECTION. COORDINATE FINAL ROUGH-IN AT TANK AND IT/CAD ROOM WITH INSTALLER AND PROJECT MANAGER.
 - PROVIDE WEATHERPROOF PULL-BOX WITH CONTACTOR WITH 120V COIL FOR EMERGENCY FUEL SYSTEM SHUT-OFF. PROVIDE LOW VOLTAGE CONTACTS WITH 120V CONTROL RELAY (OR PROVIDE CONTROL TRANSFORMER FOR 12/24V CONTROL RELAY) TO COMPLY WITH NEC 514.11(A) LINE VOLTAGE AND LOW VOLTAGE/COMMUNICATION CIRCUITS EMERGENCY DISCONNECT. PROVIDE 120V FUEL SYSTEM WP EOP PUSH-BUTTON CONNECTED TO CONTACTOR. PROVIDE SWITCHED NEUTRAL BREAKERS AT PANEL PER NEC 514.11(A) AND 514.11(C). LABEL EPO 'EMERGENCY FUEL PUMP SHUTOFF'. PROVIDE ON CONCRETE PAD WITH STRUT FRAME. MOUNT SIGN ON STRUT - FACING DRIVE.
 - POWER AND COMMUNICATION TO FUEL DISPENSER. CONFIRM ALL REQUIREMENTS WITH PROJECT MANAGER PRIOR TO ROUGH IN.
 - LIFT STATION (3HP, 208V, 3ø, 7.4FLA) ELECTRICAL CONTRACTOR SHALL PROVIDE 30A/3P, 208V, HEAVY DUTY, NEMA 3R DISCONNECT. PROVIDE STRUT RACKING FOR DISCONNECT. ELECTRICAL CONTRACTOR TO ALLOW FOR FINAL CONNECTION FUSE PER MANUFACTURER RECOMMENDATION.
 - PROVIDE KNOX KEY SWITCH. REFER TO ARCHITECTURAL DETAILS, SHEET A1.21 FOR ADDITIONAL INFORMATION.

Revisions	Date
△ CITY COMMENTS	3/10/24
△ BID CLARIFICATION	8/10/24

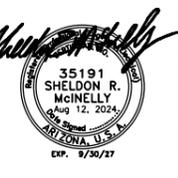

Designed By: _____
 Drawn By: _____
 Checked By: _____
 Date: 12/14/2023
 Phase: PERMIT

Perlman
 Architects of Arizona
 2929 North Central Avenue, Suite # 1600
 Phoenix, Arizona 85012
 480.951.5900 480.951.3045 F
 perlmanaz.com


FIRE STATION #74
1910 W. CHANDLER BLVD.
PHOENIX, ARIZONA 85045
 Index No: **FD57100020-3**

AKRIBIS
 MECHANICAL • PLUMBING • ELECTRICAL
 ENGINEERING, L.L.C.
 3231 SOUTH COUNTRY CLUB WAY, STE. 102 TEMPE, ARIZONA 85282
 P: (602) 393-0201 F: (602) 393-0202
 DRAWN BY: SB CHECKED BY: SM JOB NUMBER: 23224
 FOR QUESTIONS PLEASE CALL: STEPHEN BENDER

KIVA # 23-1810
 SDEV # 2300473



ELECTRICAL SITE PLAN
E1.1

Note:
 Per City of Phoenix City Code Chapter 2, section 2-28, these plans are for official use only and may not be shared with others except as required to fulfill the obligations of your contract with the City of Phoenix.

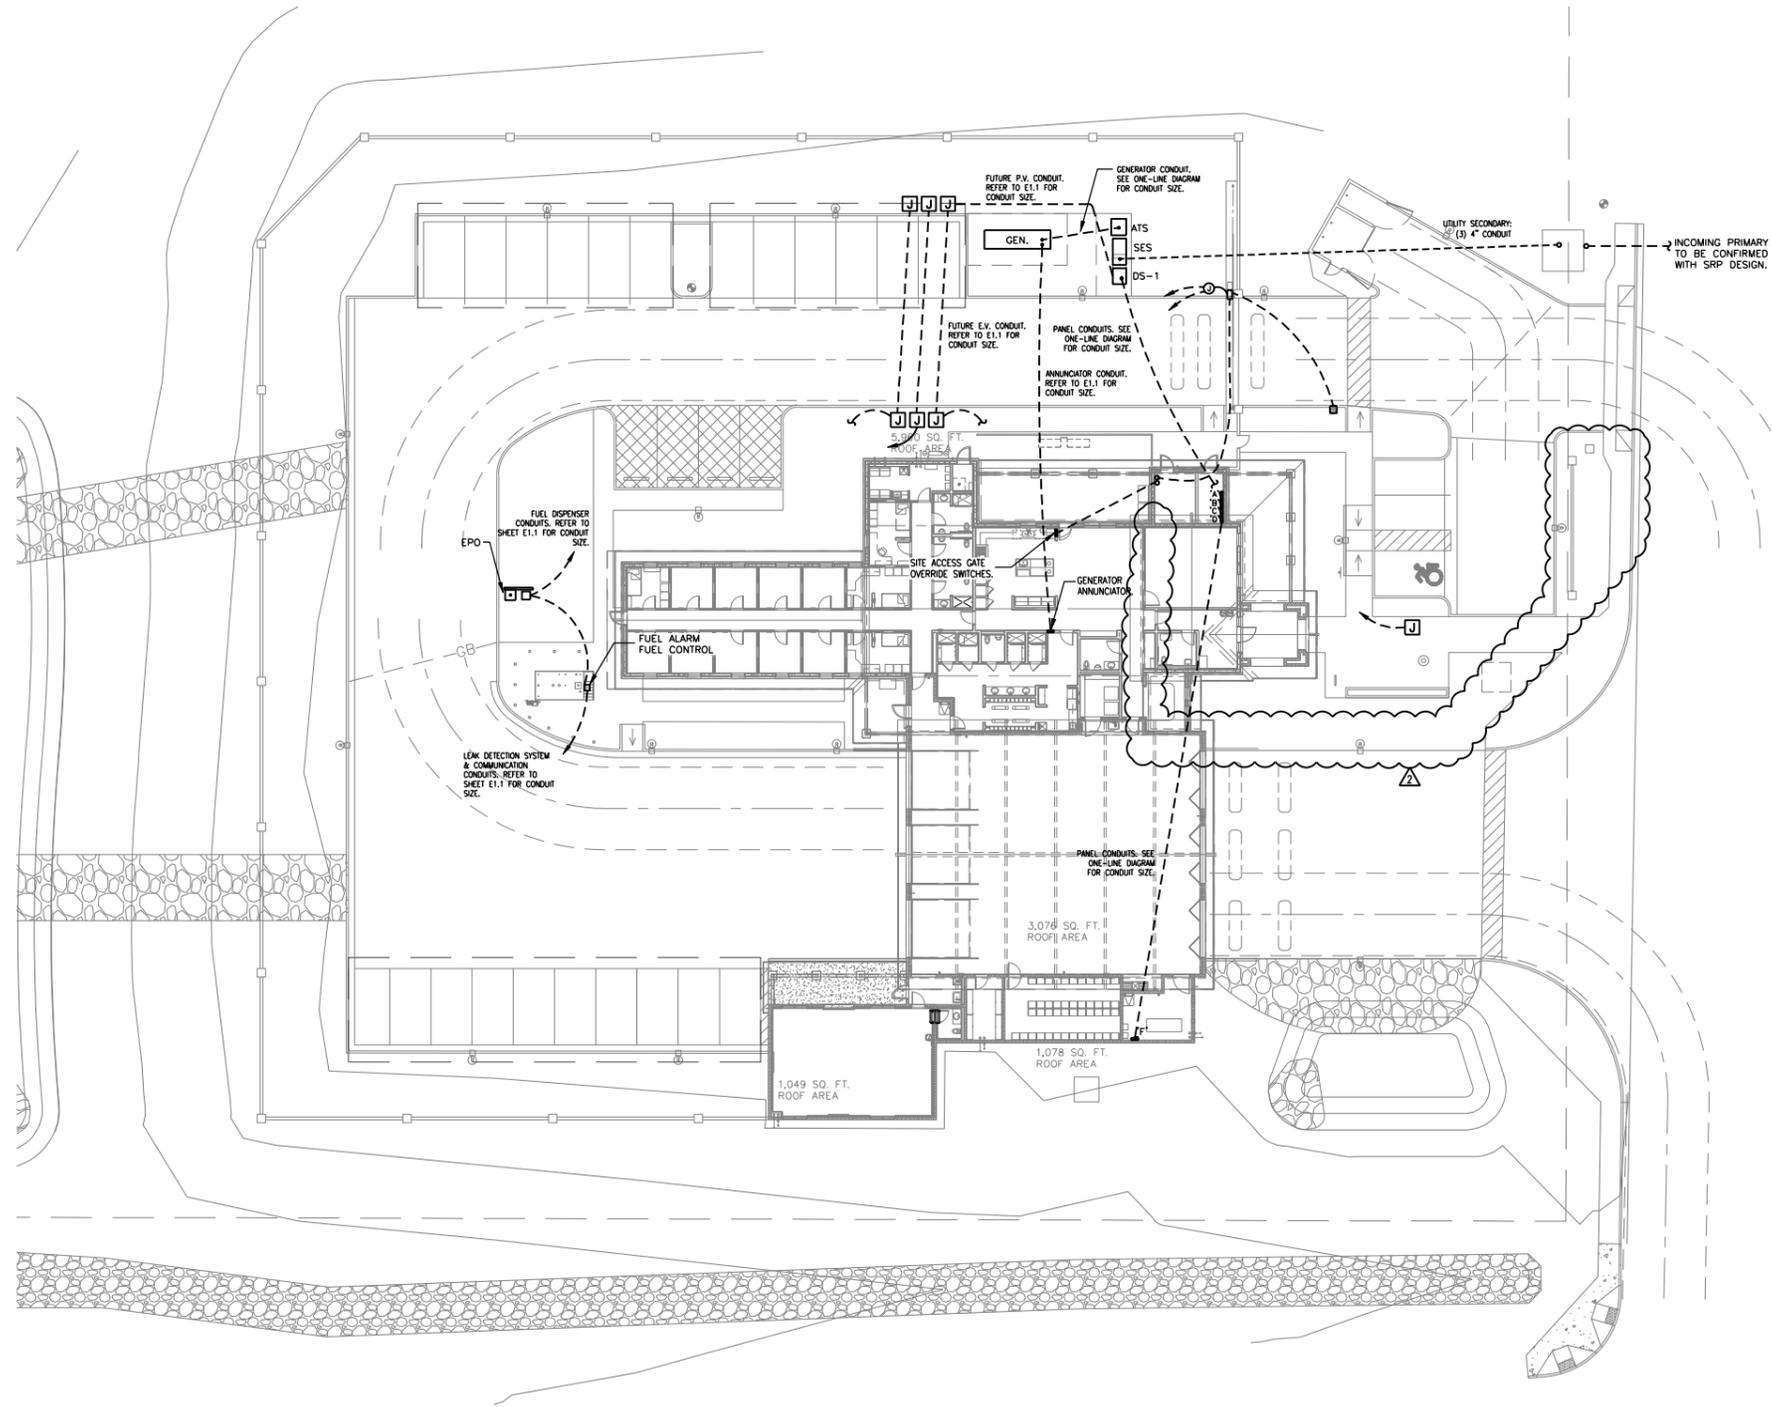


ELECTRICAL CONDUIT PLAN
 SCALE: 1" = 20'-0"

- GENERAL NOTES**
- COORDINATE ALL SITE TRENCHING AND ROUTING OF CONDUITS WITH GENERAL CONTRACTOR/OWNER PRIOR TO COMMENCEMENT OF WORK TO AVOID EXISTING UNDERGROUND UTILITIES AND CONDITIONS.
 - PROVIDE SAW-CUT, BORING, AND TRENCHING AS REQUIRED TO COMPLETE SCOPE OF WORK SHOWN. RETURN ALL CONCRETE, ASPHALT AND EARTH GRADING BACK TO ORIGINAL OR MATCHING CONDITION. REFER TO TYPICAL TRENCH DETAIL FOR ADDITIONAL INFORMATION.
 - PROVIDE #14 COPPER INSULATED TRACER WIRE SECURELY ATTACHED AT 8" ON CENTER OR WRAPPED AROUND NONMETALLIC CONDUITS AND LINES AND HAVE 12" OF WIRE EXPOSED ON ONE END PER BLUE STAKE LAW ARS 40-360.
 - PROVIDE COMPLETE MANDREL TESTING OF ALL UNDERGROUND CONDUITS AND PROVIDE 250 POUND TENSILE STRENGTH MULE TAPE WITH TRACER WIRE.
 - PROVIDE 48"-36" SWEEPS ON CONDUIT RUNS WITH NO MORE THAN TWO 90 DEGREE SWEEPS PER RUN.

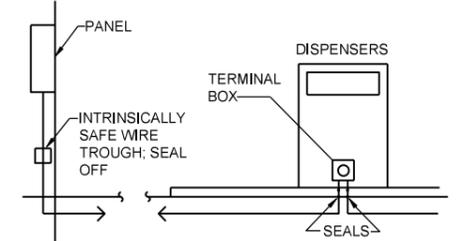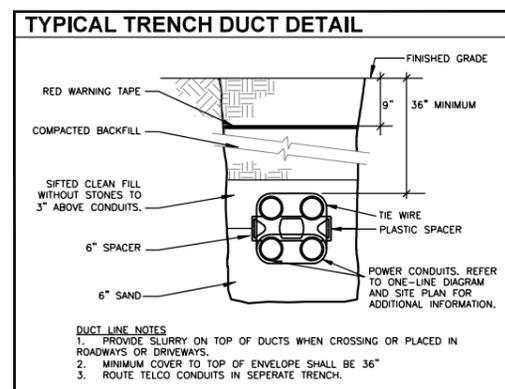

NEC ARTICLE 514.3(B)(1) - TYPICAL
 SCALE: NONE - SEALING AT DISPENSING APPARATUS

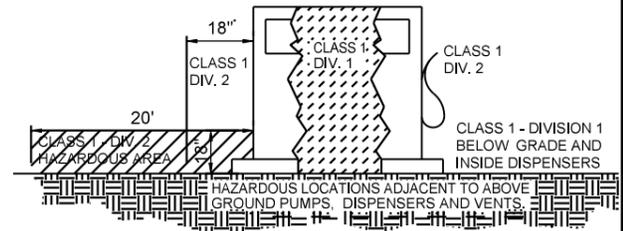

NEC ARTICLE 514 - TYPICAL
 SCALE: NONE - ABOVE GROUND MOTOR FUEL PUMPS TO DISPENSES

Revisions	Date
△ CITY COMMENTS	3/10/24
△ BID CLARIFICATION	8/17/24



Designed By: _____
 Drawn By: _____
 Checked By: _____
 Date: 12/14/2023
 Phase: PERMIT

Periman
 Architects of Arizona
 2929 North Central Avenue, Suite #1600
 Phoenix, Arizona 85012
 480.951.5900 480.951.3045 F
 perimanz.com

FIRE STATION #74
1910 W. CHANDLER BLVD.
PHOENIX, ARIZONA 85045
 Index No: **FD57100020-3**



AKRIBIS
 MECHANICAL • PLUMBING • ELECTRICAL
 ENGINEERING, L.L.C.
 3231 SOUTH COUNTRY CLUB WAY, STE. 102 TEMPE, ARIZONA 85282
 P: (602) 393-0201 F: (602) 393-0202
 DRAWN BY: SB CHECKED BY: SM JOB NUMBER: 23224
 FOR QUESTIONS PLEASE CALL: STEPHEN BENDER

KIVA # 23-1810
 SDEV # 2300473
 ELECTRICAL CONDUIT PLAN
E1.2

Note: Per City of Phoenix City Code Chapter 2, section 2-28, these plans are for official use only and may not be shared with others except as required to fulfill the obligations of your contract with the City of Phoenix.



SCHEMATIC
ZB-36-01
ZC-31-04

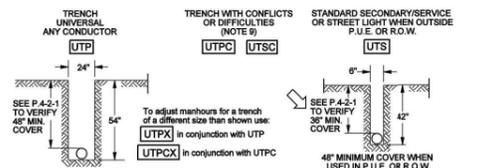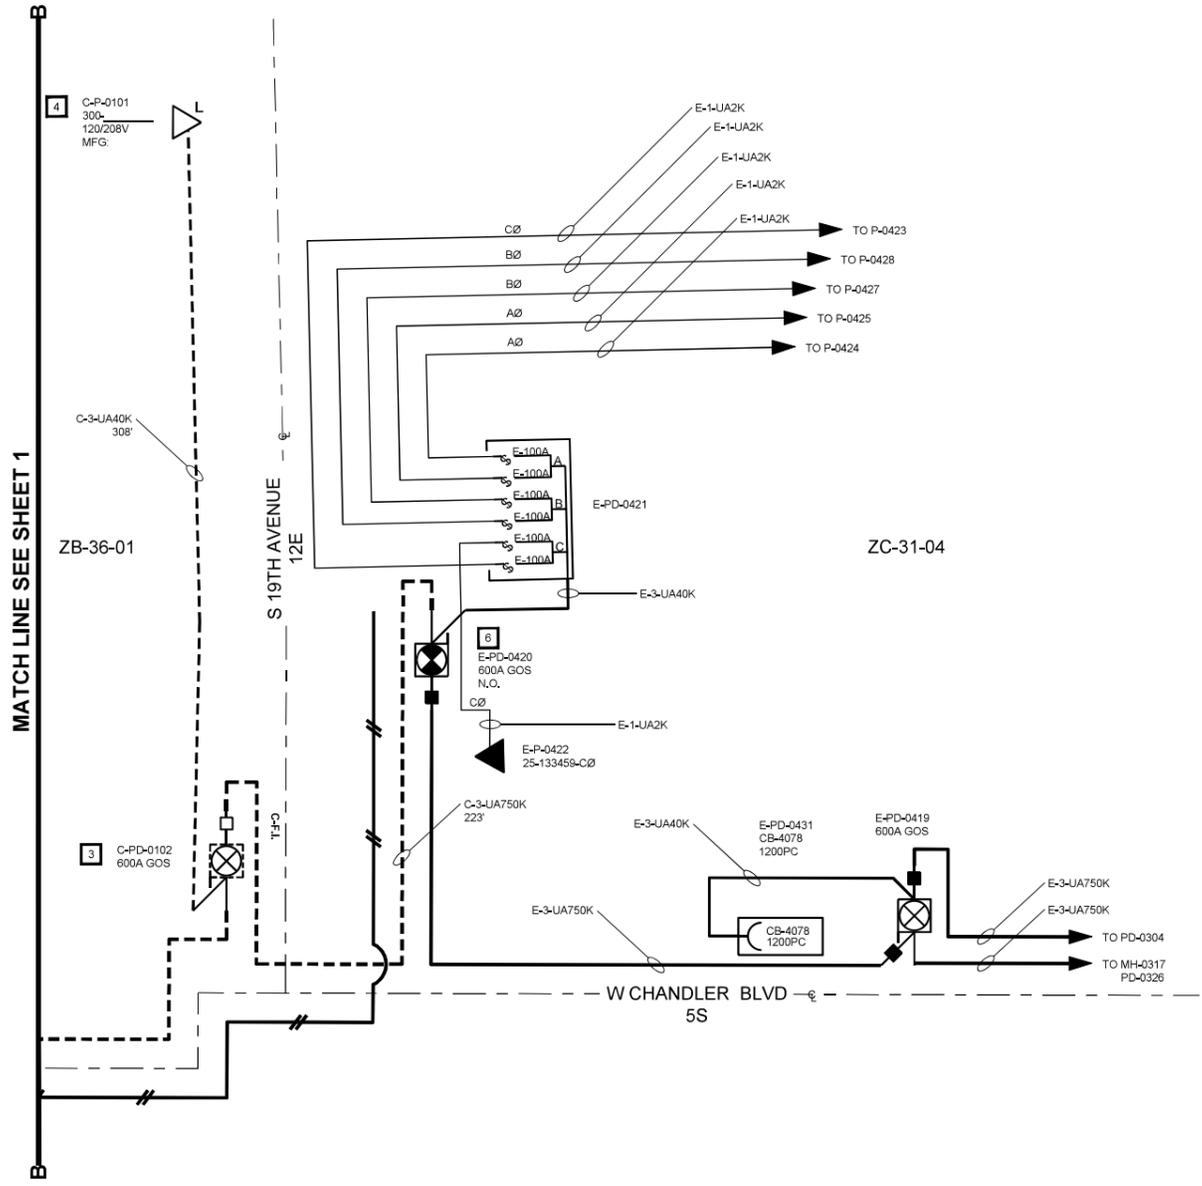


- NOTES:**
- Trench depths and conduit cover are to be measured from final grade stakes. All trench depths or conduit cover requirements specified on a job drawing shall be followed.
 - These trench codes provide man-hours for excavation only and do not provide for trench backfill.
 - The total trench footage length will be shown in the grid as standard trench, either UTP for primary or UTS for secondary, street light, or service. When trench is provided by customer, this is the only coding required on the job grid.
 - Non standard trench locations will be identified on the job order sketch with required width and depth dimensions given.
 - When trenching is provided by SRP, non standard trenches shall have 2 compatible unit codes in the grid, UTP plus the UTPX, to adjust the time for digging.
 - When specified depth cannot be obtained because of solid rock, a minimum earth cover of 24" is acceptable, provided a minimum 2" encasement of concrete surrounds the conduit.
 - Use example shown to figure length of UTPX trench, unless the entire trench is non standard.
- UTPX quantity = the factor from the UTPX Chart multiplied by the trench footage length which is non-standard, as calculated in item 4. If multiple calculations for non-standard trench are made, add all totals together, only one entry is needed for UTPX quantity in the grid.
 - If secondary/service or street light must be placed in P.U.E. or road R.O.W. use UTP trench dimensions and enter UTS as the compatible unit.
 - Provide 1.5 times regular man-hours.
 - Trench bottom to be smooth and free of sharp rocks. Where excavation is in rock, bottom of trench to have protective layer of clean, level, tamped backfill or sand.

Underground Distribution Construction Standards SRP PROPRIETARY MATERIAL	REV. CORRECTED TRENCH DEPTH TYPO.	Page 1 of 2
	TRENCHING EXCAVATION CODES	ISSUE DATE: 01/15/87
	6-11-1	REV. DATE: 03/06/13 APPROVAL: B. PRIEST 801E130.DGN


- NOTES**
- Minimum vertical or horizontal separations between electric conduit systems and communications conduit systems (NESC Rule 320B2):
 - Minimum clearance between an electric conduit system and other existing underground structures or utilities (Note 4):
 - Horizontal clearance for parallel structures (NESC Rule 320B):
 - An alternative to 12" of 85-90% compacted earth is a rigid support for the upper structure to prevent it from transferring any direct load to lower structure.
 - Conduit should be installed as far as practical from a water main to protect it from being undermined if the main breaks.
 - Municipals and other utilities may have additional requirements.

Electric Service Specifications SRP PROPRIETARY MATERIAL	CLEARANCES UNDERGROUND CONDUIT	ISSUE DATE: 04/19/88
	5-3	REV. DATE: 10/29/12
		APPROVAL: W. LARAMEE 800E140.DGN

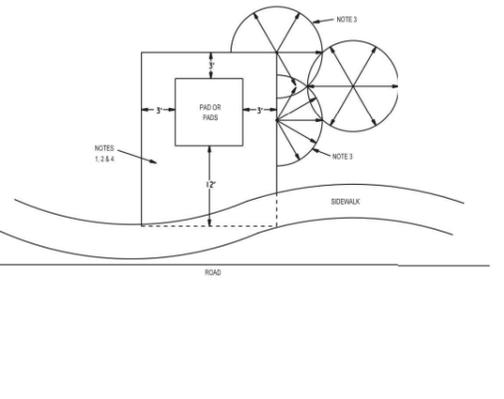

- NOTES**
- Easement grantor shall maintain a clear area that extends 3' from and around all edges of all transformer pads and other equipment pads and a clear operational area that extends 12' immediately in front of all transformer and other equipment openings. Do not place obstructions, trees, shrubs, fixtures or permanent structures within aforementioned areas. Easement documents may supersede these requirements.
 - This same clear area shall be dry landscaped.
 - Direct sprinkler heads away from pad-mounted equipment, as shown above. Sprinkler heads shall not spray on pad-mounted equipment or dry landscaped area around equipment.
 - Dry landscape surface may be native soil, concrete, asphalt pavement or crushed granite or gravel with a maximum particle size no greater than 1".
 - A border curb is required if SRP installs the landscape.

Electric Service Specifications SRP PROPRIETARY MATERIAL	CLEARANCES DRY LANDSCAPE CONTROLLED AREA DETAIL	ISSUE DATE: 03/29/11
	5-10	REV. DATE: 10/31/12
		APPROVAL: W. LARAMEE 800E133.DGN

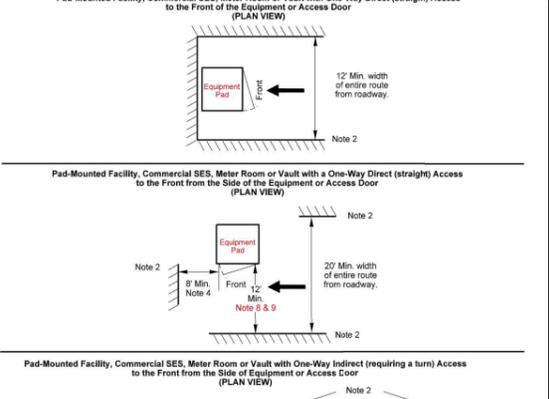

- NOTES**
- Easement grantor shall maintain a clear area that extends 3' from and around all edges of all transformer pads and other equipment pads and a clear operational area that extends 12' immediately in front of all transformer and other equipment openings. Do not place obstructions, trees, shrubs, fixtures or permanent structures within aforementioned areas. Easement documents may supersede these requirements.
 - This same clear area shall be dry landscaped.
 - Direct sprinkler heads away from pad-mounted equipment, as shown above. Sprinkler heads shall not spray on pad-mounted equipment or dry landscaped area around equipment.
 - Dry landscape surface may be native soil, concrete, asphalt pavement or crushed granite or gravel with a maximum particle size no greater than 1".
 - A border curb is required if SRP installs the landscape.

Electric Service Specifications SRP PROPRIETARY MATERIAL	CLEARANCES VEHICLE ACCESS REQUIREMENTS PAD-MOUNTED FACILITIES & 10' TRANSFORMERS	ISSUE DATE: 03/09/11
	5-19	REV. DATE: 03/01/13
		APPROVAL: J. ROSSINI 800E319.DGN

CONTACTS
DESIGN CONSULTANT:
 JEREMY HUNT
 OFFICE: (602) 236-4858
 MOBILE: 480-392-7966

PROJECT LEADER:
 VICTOR CUEVAS
 MOBILE: 602-376-5538

CONSTRUCTION CONSULTANT:
 MARCEL KUNISKI
 MOBILE: 480-793-0157

INSPECTIONS:
 OFFICE: 602-236-0676

NATURAL GAS

JOBNAME: COP - FIRE STATION 74
ADDRESS/LOCATION: 19TH AVE AND CHANDLER BLVD, PHX
CONTACT: VERONICA ALVAREZ **PHONE:** 602-534-8136



BILLING ACCT NO.: _____ **MAP 1/4:** NE S 36 T 1S R 2E
FIS JO: _____ **COORDS:** 11 15/16E - 5 1/5S
WAM WO: T3567105 **WAM VERSION:** _____

COST CENTER: 22640
ROUTING CODE: DDY+8


CONTACT: Arizona 911 or Best Free Fall, Working Fire Station you have jurisdiction. **SRP** Call 911 in all Arizona Counties.



CONDUIT ONE LINE

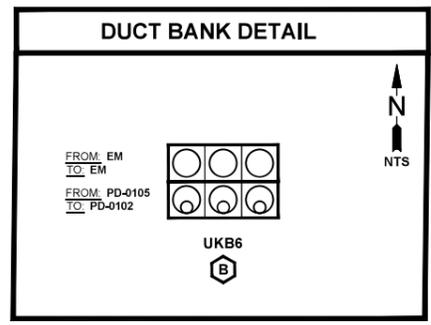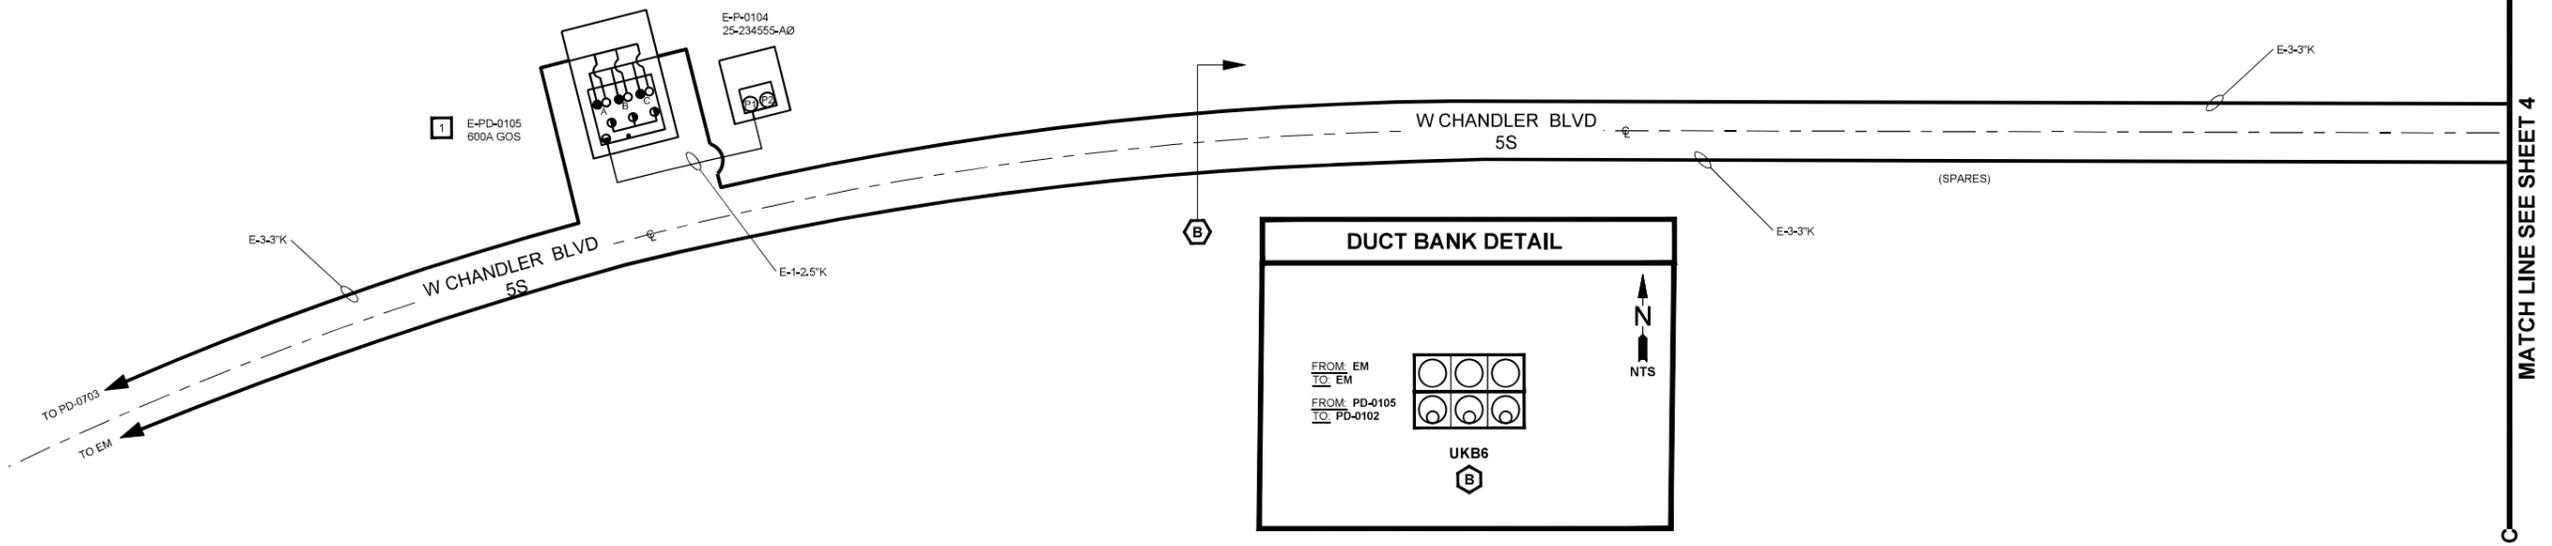

Pad-Mounted Facilities Access Height Clearance Requirements (PROFILE VIEW)

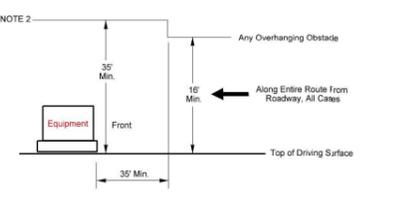

- NOTES**
- These required access dimensions are in addition to the electrical clearance standards. See SRP's Electric Clearance Standards.
 - The Boundary of Traveled Way is any permanent obstacle to vehicle access; (i.e., building, fence, Customer equipment, landscape, ditch, curb, guard post, etc.).
 - If proposed access route is different than any of the ones shown in these details, consult SRP Distribution Design.
 - 8' minimum clear space is required for backing and positioning beyond the equipment.
 - If SRP pad is over 40' beyond corner of turn, the width of the Traveled Way may be reduced from 30' to 20'.
 - For meter room or vault doors, the width of the Traveled Way may be reduced from 30' to 20'.
 - There are additional access requirements for vaults with hatches. Consult SRP Distribution Design.
 - When a commercial SES/meter room and the SRP transformer share the same Traveled Way, increase distance to 24'.
 - If guard posts are to be installed to protect equipment, the width of the Traveled Way shall be measured from the outside edge of guard post.

Electric Service Specifications	REV. INCLUDE SHARED ACCESS BTWN XFAM AND SES	PAGE 2 OF 2
Clearances	VEHICLE ACCESS REQUIREMENTS	ISSUE DATE: 02/09/11
PAD-MOUNTED FACILITIES & 10 TRANSFORMERS		REV. DATE: 02/01/12
5-20		APPROVAL: J. RODRIGUEZ
		8509E347.DGN

SOIL TYPES, BACKFILL MATERIAL AND COMPACTION REQUIREMENTS

MAG SPECIFICATION 601-2 <i>Modified to meet most MAG Agency requirements.</i>	FROM SURFACE TO 2' BELOW SURFACE	FROM 2' BELOW SURFACE TO TRENCH BOTTOM
A. Under or within 2' existing or proposed pavement, curb, gutter or sidewalk	Native.....95% Granular.....100%	AI 95%
B. On any utility easement street, road or alley ROW outside limits of A	90%	90%*
C. Around and under any structures or pad-mounted equipment or exposed utilities	95%	35%
D. All other areas	80%	30%

*Applicable from 1' above conduit, 85% below.


NOTE: Do not use machine compaction within 6" of cable or conduit.

SLURRY BACKFILL MIXES (NO COMPACTION REQUIRED)

MAT. ITEM #	ABBREV.	SLURRY TYPE	DESCRIPTION	COARSE AGGREGATE ASTM C33	FINE AGG.	SLJMP RANGE	MIN. CEMENT CONTENT (LBS/ CU. YD.)
0000100	ASB	Aggregate Slurry Backfill	Washed gravel and sand or clean ABC, with cement, trench backfill backfill around wood and concrete transmission line poles and in trenches (no loads).	NO. 67 [3/4" (19mm) NOM. MAX.]	NOTES 11 & 12	6"-9"	NONE
0000104	CLSM 1/2 SACK	Controlled Low Strength Material w/ 1/2 Sack Cement PCY	Washed gravel and sand or clean ABC, with cement, trench backfill (low load areas-streets and lots).	MIXES IN ACCORDANCE WITH MAG 728 (13)			
0000105	CLSM 1 SACK	Controlled Low Strength Material w/ 1 Sack Cement PCY	Washed gravel and sand or clean ABC, with cement, trench backfill in low load areas (streets and lots). Use in lieu of CLSM 1/2 Sack as required by cities.				
0000106	CLSM 1 1/2 SACK	Controlled Low Strength Material w/ 1 1/2 Sack Cement PCY	Washed gravel and sand or clean ABC, with cement, structural backfill under foundations and as thermal fill and/or mechanical protection of duct banks.				
000109	DBS	Duct Bank Backfill w/ Sand Slurry	Grout for pumping around conduits placed in pipe sleeves.	NONE	NOTE 11	6"-9"	376




Electric Service Specifications	REV. INCLUDE SHARED ACCESS BTWN XFAM AND SES	PAGE 2 OF 2
TRENCHING AND CONDUIT	SOIL TYPES, BACKFILL MATERIAL AND COMPACTION REQUIREMENTS	ISSUE DATE: 06/29/90
6-22		REV. DATE: 11/01/12
		APPROVAL: W. LARSEN
		8509E2166-03.DGN

3Ø Transformer Access Height Clearance Requirements (PROFILE VIEW)

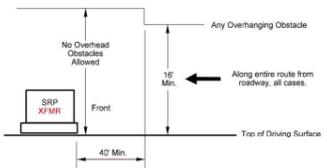

- NOTES**
- These required access dimensions are in addition to the electrical clearance standards. See SRP's Electrical Clearance Standards book.
 - The Boundary of Traveled Way is any permanent obstacle to vehicle access (i.e., building, fence, Customer equipment, landscape, ditch, curb, etc.).
 - These requirements are based on maneuvering requirements of the OMC. If these cannot be obtained, a crane will have to be used. Consult SRP Distribution Design.
 - 8' minimum clear space is required for backing and positioning beyond the equipment.
 - Access way must support 80,000 lbs. GVW.
 - Consult Distribution Design for vehicle access to multiple pad-mounted equipment.
 - When a commercial SES/meter room and the SRP transformer share the same Traveled Way, increase distance to 24'.
 - If guard posts are to be installed to protect equipment, the width of the Traveled Way shall be measured from outside edge of guard post.

Electric Service Specifications	REV. INCLUDE SHARED ACCESS BTWN XFAM AND SES	PAGE 2 OF 2
Clearances	VEHICLE ACCESS REQUIREMENTS	ISSUE DATE: 02/09/11
3Ø TRANSFORMERS		REV. DATE: 02/01/12
5-22		APPROVAL: J. RODRIGUEZ
		8509E348.DGN

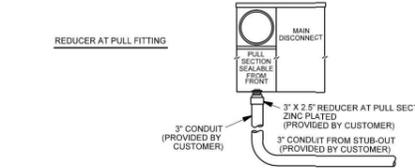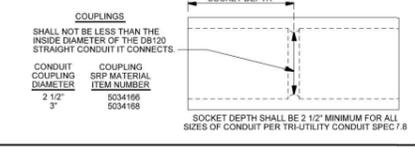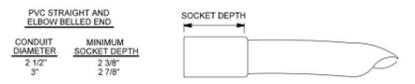

Electric Service Specifications	REV. INCLUDE SHARED ACCESS BTWN XFAM AND SES	PAGE 2 OF 2
TRENCHING AND CONDUIT	SIZES & SPECIFICATIONS	ISSUE DATE: 03/13/91
BELLED ENDS AND FITTINGS		REV. DATE: 05/03/10
6-3		APPROVAL: W. LARSEN
		8509E127.DGN

SECTION 7: TRANSFORMER PADS


- NOTES**
- Three-phase transformer pads shall be pre-cast construction. Size is shown on the SRP design. Customer shall provide and install pad, secondary window cover plate (if required), ground rod, and all necessary conduit and backfill material. See Contractor-Supplied Material section for approved suppliers. Contact Distribution Design for transformer vault installations.
 - Pad shall be located to allow access and oriented to provide a minimum of 12' of clear working space at front of unit. Maintain minimum clearance of 3' at sides and 18" at back of pad (see page 5-12, items 5-10).
 - Conduits shall stub up 2" above final top surface of pad. Temporary conduit plugs (no duct tape) shall be installed in all conduits. A flat pull tape shall be tied to conduit plugs in the low voltage (secondary) opening/window. End bell fittings shall not be installed on any conduit stub-ups at the transformer. Size and number of conduits are shown on the SRP design.
 - Service conduit stubbed up in the rear off the pull box/window shall stub up in rear of the SES pad. Each consecutive row shall match the conduit stub up location in the transformer and SES. Straight runs of racked and encased service conduits of 50 feet and greater may be rolled to meet the above requirements.
 - In the "low voltage" (secondary) opening with more than 13 conduits, a pull box is required under the pad secondary window. See page 7-4, Secondary Pull-Box Placement for 3Ø Transformer, 750 - 3,000 KVA.
 - A 5/8" x 8" copper clad ground rod shall be installed in the "high voltage" opening of the transformer pad. The top of the ground rod shall be 2" above top of transformer pad.
 - For service conduits not requiring racking and encasement, backfill under pad shall be 1/2 sack CLSM (controlled low strength material), SRP material item number 5075313 consisting of washed gravel (#57 aggregate per ASTM C33) and sand slurry stabilized with Portland cement (1/2 sack Portland cement per cubic yard) in accordance with MAG section 728. For service conduits requiring racking and encasement, backfill shall be 1-1/2 sack CLSM. SRP item number 5075315 matching the conduit encasement backfill. SRP inspectors shall approve the subgrade before the pad is placed.
 - Top of pad shall be 4" minimum above surrounding grade and at sufficient elevation to prevent flooding.

Electric Service Specifications	REV. INCLUDE SHARED ACCESS BTWN XFAM AND SES	PAGE 2 OF 2
TRANSFORMER PADS	PRECAST PAD FOR THREE-PHASE	ISSUE DATE: 11/01/12
0-3,000 KVA		REV. DATE: 08/15/18
7-3		APPROVAL: N. SAGGAR
		8509E338.DGN

ELECTRICAL SPECIFICATIONS	CONTACTS	DESIGN CONSULTANT: JEREMY HUNT OFFICE: (602) 236-4858 MOBILE: 480-392-7966	PROJECT LEADER: VICTOR CUEVAS MOBILE: 602-376-5538	CONSTRUCTION CONSULTANT: MARCEL KUNISKI MOBILE: 480-793-0157	INSPECTIONS: OFFICE: 602-236-0676	NATURAL GAS <input type="checkbox"/>	JOBNAME COP - FIRE STATION 74 ADDRESS/LOCATION 19TH AVE AND CHANDLER BLVD, PHX CONTACT VERONICA ALVAREZ PHONE 602-534-8136	BILLING ACCT NO. _____ FIS JO _____ MAP 1/4 NE S 36 T 1S R 2E 40/ACRE ZB-36-01 COORDS 11 15/16E - 5 1/5S WAM WO T3567105 WAM VERSION _____	COST CENTER 22640 ROUTING CODE DDY+8	SHEET NUMBER 03 OF 06
	QR CODE									

CONDUIT ONE LINE


MATCH LINE SEE SHEET 3

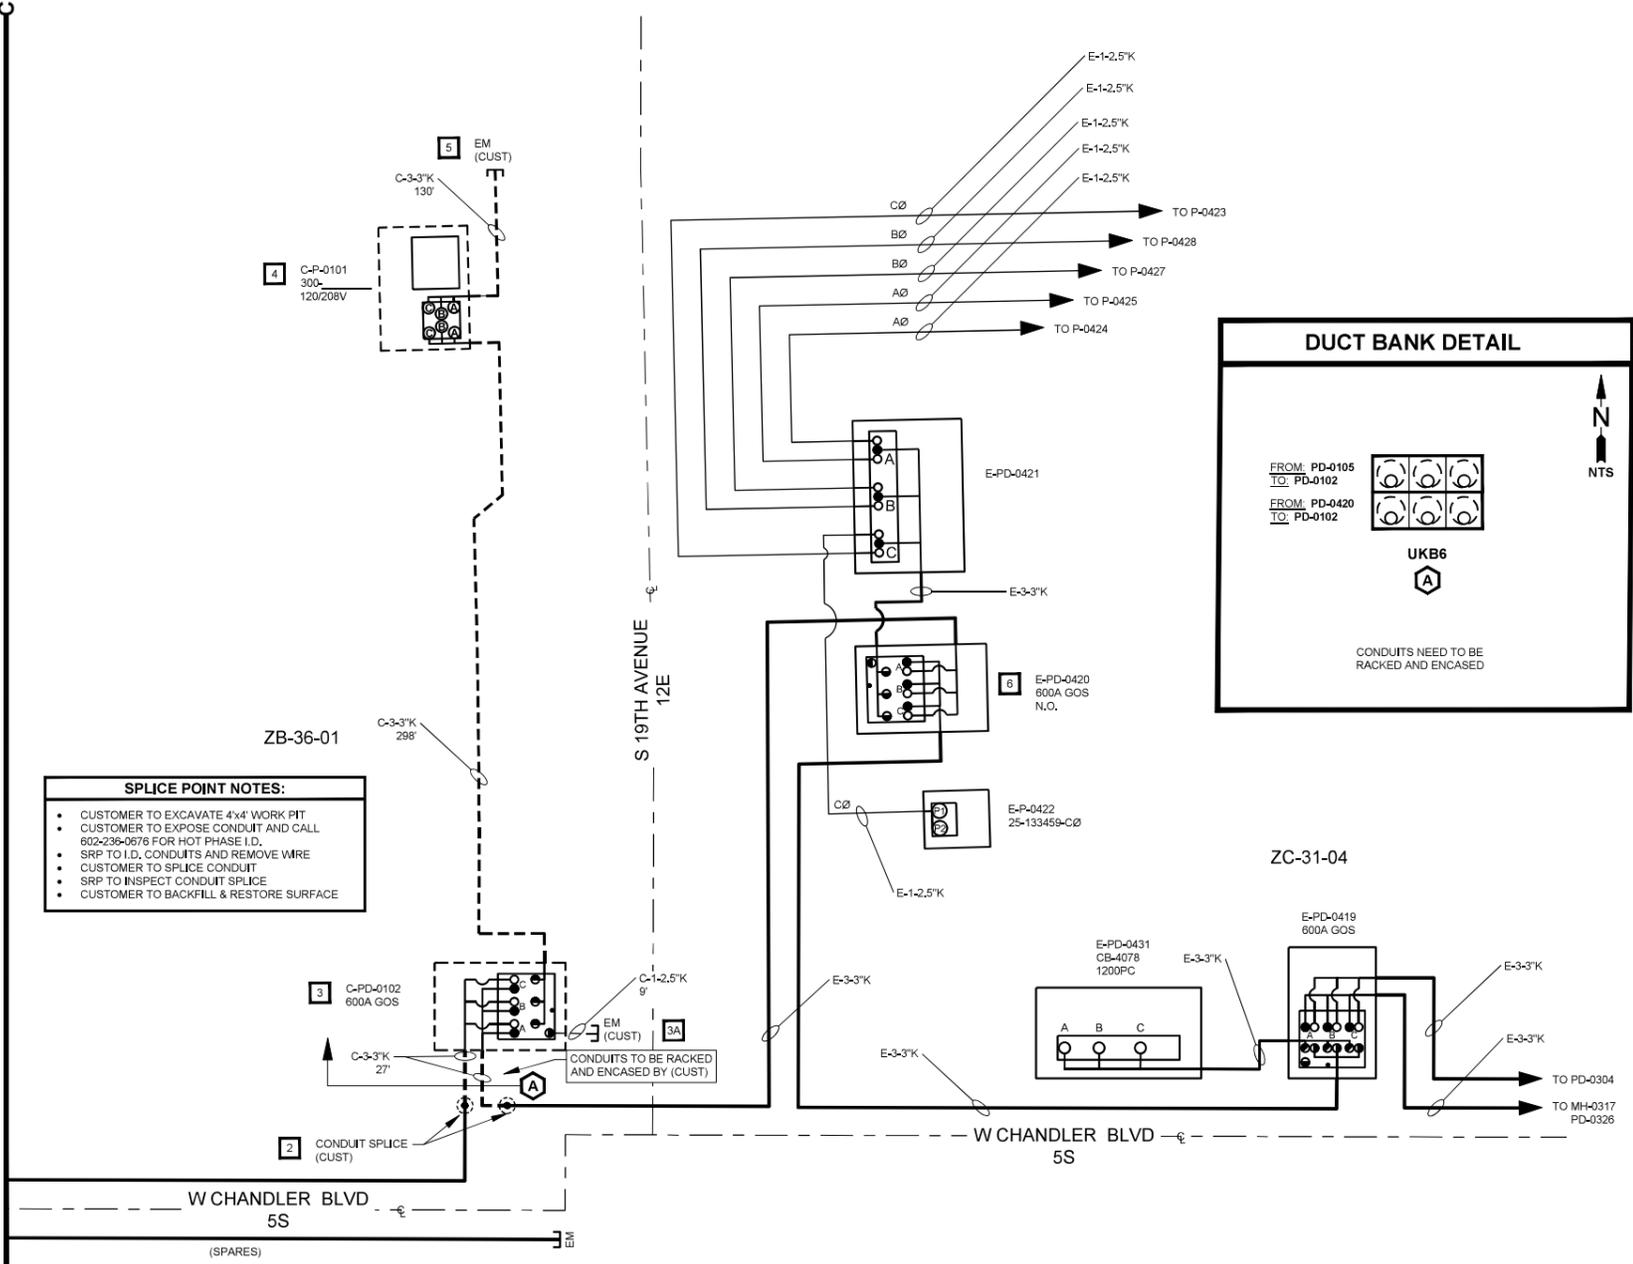

SPLICE POINT NOTES:

- CUSTOMER TO EXCAVATE 4x4 WORK PIT
- CUSTOMER TO EXPOSE CONDUIT AND CALL 602-236-0576 FOR HOT PHASE I.D.
- SRP TO I.D. CONDUITS AND REMOVE WIRE
- CUSTOMER TO SPLICE CONDUIT
- SRP TO INSPECT CONDUIT SPLICE
- CUSTOMER TO BACKFILL & RESTORE SURFACE

SECTION 7: TRANSFORMER PADS

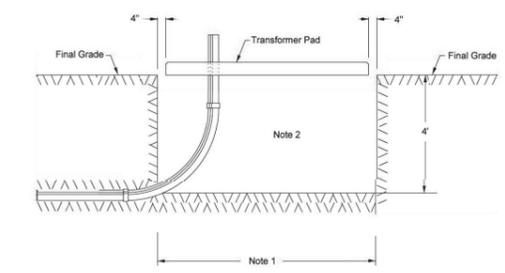

NOTES

- Excavate 4' below pad. Pit shall extend on all sides 4" past edge of pad.
- Backfill material under transformer pad shall be CLSM 1/2" sack material item 5075313. For installations in which service conduits require racking and encasement, backfill material shall be 1-1/2" sack CLSM material item 5075315.


Electric Service Specifications	REV. UPDATED TITLE BLOCK & CHANGED PAGE # FROM 7-5	ISSUE DATE: 01/23/19	Page 1 of 1
SRP	TRANSFORMER PADS	REV. DATE: 06/16/19	ISSUE DATE: 04/15/19
PROPRIETARY MATERIAL	THREE-PHASE TRANSFORMER INSTALLATION REINFORCED EXCAVATION	APPROVAL: N. Sabban	APPROVAL: W.LAKRAMI
	7-5	8506238.DGN	8506232.DGN

SERVICE ENTRANCE SECTION ADDRESSING & IDENTIFICATION


- I. Addressing - Job Location**
- The assignment of street addresses is performed according to the "Address and Street Assignment Policy" adopted by the MAG or AHJ.
 - Any variance from the addresses assigned by the municipality may delay the energizing of electrical service. Clearances are dispatched to SRP using the address, apartment number, suite number, etc., originally assigned. SRP will accept numeric designations only.
 - The Customer shall furnish SRP with the assigned address corresponding to the job location when the application for electric service is made to SRP. This address, including the lot number, if any, shall be posted in a conspicuous location at the job site to assist SRP personnel in performing their work as scheduled.
 - All individual homes, suites, units, etc., SES attached to building wall, address shall be posted on the front of the unit and easily visible from the ROW, using 2" height and width (minimum) letters and numbers (not painted).
- II. SES identification by customer using permanent metal tags (not painted):**
- Single family dwellings, SES attached to dwelling wall, no addressing requirements at the meter.
 - Pedestals or meters mounted on equipment structure: Address and unit number as necessary shall be attached to the exterior of a panel not removable by the Customer (sealed panel) directly adjacent to each meter and repeated at each corresponding main breaker.
 - Pull sections with multiple meters attached to building wall: Address shall be attached to the exterior of the pull section panel not removable by the Customer (sealed panel). Unit number shall be attached to the exterior of a panel not removable by the Customer (sealed panel) directly adjacent to each meter and repeated at each corresponding main breaker.
 - Enclosed SES: Address shall be attached to the exterior door of the SES, unit number shall be attached to the interior of a panel not removable by the customer (sealed panel) directly adjacent to each meter and repeated at each corresponding main breaker.

Electric Service Specifications	METERING & SES SERVICE ENTRANCE SECTION ADDRESSING & IDENTIFICATION	ISSUE DATE: 04/15/19	Page 1 of 1
SRP		REV. DATE: 11/05/13	ISSUE DATE: 04/15/19
PROPRIETARY MATERIAL		APPROVAL: W.LAKRAMI	APPROVAL: W.LAKRAMI
	9-10	8506232.DGN	8506232.DGN

E. The identifying Labeling for SESs shall be metal riveted to the meter cover (see page 11-46, detail titled "Labeling SES, Meter Cover Panels"). If the main breakers are not installed directly adjacent to the meter, both the meter and the main breaker shall be identified with individual labels. SRP may require the Customer or their contractor to open the apartments or suites at the time the meters are set in order to verify that each meter socket serves the apartment or suite indicated by the marking labels.

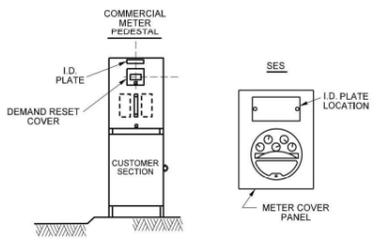


F. In the case of multiple buildings, the building or unit number and street address shall be identified on the pull section in the manner described below.

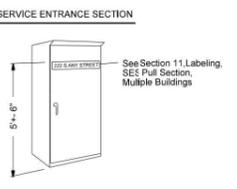

Electric Service Specifications	METERING & SES SERVICE ENTRANCE SECTION ADDRESSING & IDENTIFICATION	ISSUE DATE: 04/15/19	Page 2 of 2
SRP		REV. DATE: 11/02/13	ISSUE DATE: 04/15/19
PROPRIETARY MATERIAL		APPROVAL: W.LAKRAMI	APPROVAL: N. Sabban
	9-11	8506232.DGN	8506232.DGN

SECTION 11: CONTRACTOR-SUPPLIED MATERIAL

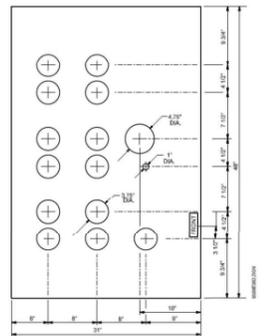

SRP Material Item No. 5031741	
Description	Conduit
Noun	Stub-up form
Adjective	13-3/8", 14-7/8" & 1-1/4" holes per drawing
Sizes	Recycled or new plastic
Type	For pad-mounted switch 5034828
Use	Made from polypropylene or polyethylene, SM-647561-5031741
Special Ref.	
Approved Suppliers	Rocky Mountain Template Underground Supply

NOTE: "FRONT" to be stamped or labeled into or on plastic and shall be of sufficient size to be easily readable.

Electric Service Specifications	CONTRACTOR-SUPPLIED MATERIAL CONDUIT STUB-UP FORM SPACER 13-3/8", 14-7/8" & 1-1/4" HOLES	ISSUE DATE: 06/02/14	Page 1 of 1
SRP		REV. DATE: 06/26/16	ISSUE DATE: 06/02/14
PROPRIETARY MATERIAL		APPROVAL: N. Sabban	APPROVAL: W.LAKRAMI
	11-26	85011-26.DGN	85011-26.DGN

CONTACTS

DESIGN CONSULTANT:
JEREMY HUNT
OFFICE: (602) 236-4858
MOBILE: 480-392-7966

PROJECT LEADER:
VICTOR CUEVAS
MOBILE: 602-376-5538

CONSTRUCTION CONSULTANT:
MARCEL KUNISKI
MOBILE: 480-793-0157

INSPECTIONS:
OFFICE: 602-236-0676

NATURAL GAS

JOBNAME: COP - FIRE STATION 74
ADDRESS/LOCATION: 19TH AVE AND CHANDLER BLVD, PHX
CONTACT: VERONICA ALVAREZ **PHONE:** 602-534-8136



BILLING ACCT NO.: _____
FIS JO: _____ **MAP 1/4:** NE S 36 T 1S R 2E
40/ACRE: ZB-36-01 **COORDS:** 11 15/16E - 5 1/5S
WAM WO: T3567105 **WAM VERSION:** _____

COST CENTER: 22640
ROUTING CODE: DDY+8

SHEET NUMBER: 04 OF 06




MAINLINE

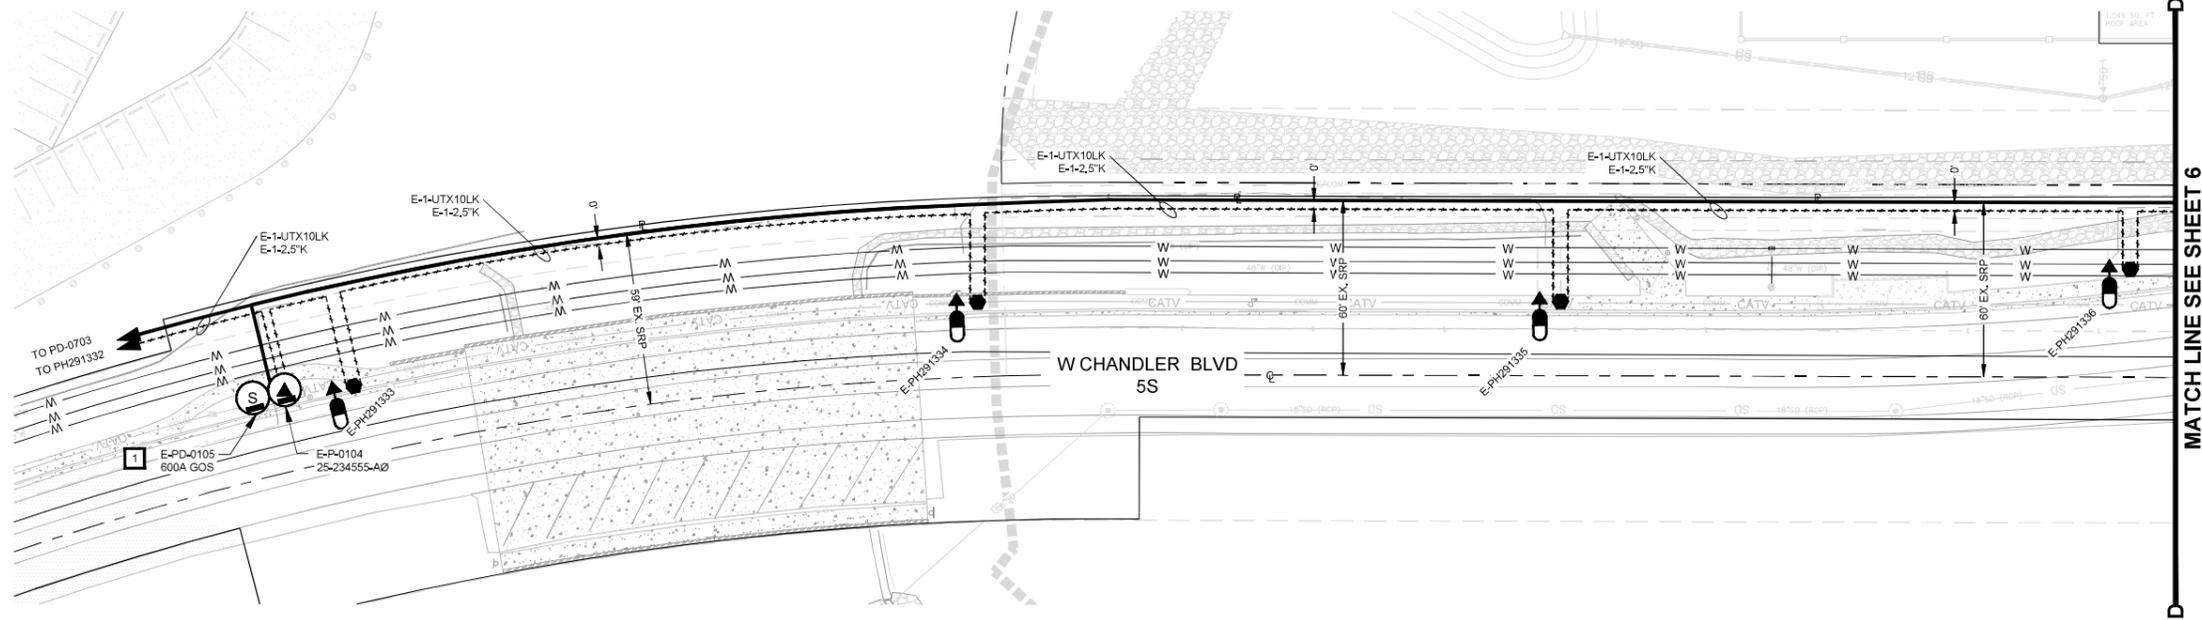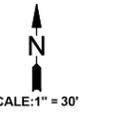

MATCH LINE SEE SHEET 6

Dedicated 3" of concrete in front of the SES, supplied and installed by customer.
 EXCEPTION: 5' drivable path (except for drainage slope).
 Pad shall be at the same elevation as SES pad. SES installed on an elevated (housekeeping) pad above the workspace is not permitted.
 EXCEPTION: NEMA 1 enclosures installed in meter rooms. Parking not allowed within 5' of SES.
 NOTE: Drainage away from cabinet.

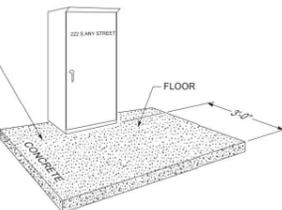

- Switchboard Service Section Defined
- A standard switchboard service section is a free-standing unit of switchgear that contains bussing for the termination of service entrance conductors, bussing for the connection and mounting of current transformers, panel for the installation of the test switch and meter socket, a service main disconnect switch or breaker, and in many cases, distribution feeder breakers or switches.
 - Switchboard service sections, approved for use in the area served by SRP, are to be built to the standards developed by the EUSERC, which are available to the Customer and contractor through electric wholesale distributors.
 - If service riser conductors are to be paralleled, they shall be paralleled in separate conduits. The only acceptable method is to install one of each phase conductor and neutral in each conduit (i.e., ABC of a 3-wire service or ABCN of a 4-wire service). If overhead service risers are to be paralleled, there shall be a maximum of two conductors per phase.
 - Overhead service entrance conductor requirements exceeding 800 amps or exceeding two 750 MCM conductors per phase shall be bus bar construction.
 - Submit electronic copies of the plans (PDF format preferred) for all proposed SES, 400 amps or larger, to shopdraw@srpnet.com for approval prior to construction of the service section. Drawings must be labeled with the Customer's name, job address, SRP job number or account number, and contractor's name and contact phone number.
 - All SES shall be braced for the total available fault current.
 - The above requirements apply to both overhead and underground SES.
 - Barriers shall be constructed from 16 gauge (min.) steel and secured so as not to be removable from either the Customer's section or exterior.
 - See page 9-43 for door locking requirements.

Switchboard Service Section Defined

- Pages 9-40 thru 9-61 are EUSERC drawings illustrating the metering and pull section requirements.

Electric Service Specifications	REV ADDED NOTE	ISSUE DATE: 04/19/05
	METERING & SES SWITCHBOARDS GENERAL INFORMATION	REV DATE: 01/26/13
PROPRIETARY MATERIAL	9-42	APPROVAL: N. Sabaiah
		ES09E100.DGN


SECTION 11: CONTRACTOR-SUPPLIED MATERIAL



SRP Material Item No. 5035671	
Description	
Noun	Marker
Adjective	Buried electronic
Size	15" diameter, 1" thick
Type	A tuned passive element
Style	Hermetically sealed
Use	To mark sub-surface facilities
Approved Supplier	Part Number
3M / MSC Industrial Supply	1251

Electric Service Specifications	CONTRACTOR-SUPPLIED MATERIAL BURIED ELECTRONIC MARKER 15" DIAMETER, 1" THICK	ISSUE DATE: 03/09/05
	11-22	REV DATE: 11/06/13
PROPRIETARY MATERIAL		APPROVAL: W. Lammie
		ES011-22.doc

SECTION 11: CONTRACTOR-SUPPLIED MATERIAL



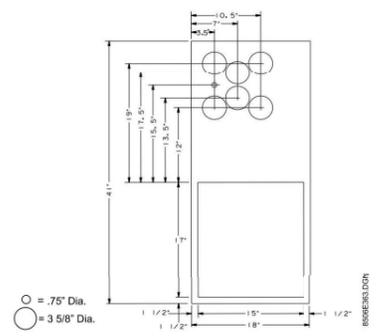


SRP Material Item No. 5031854	
Description	
Noun	Spacer
Adjective	Conduit stub-up form
Size	6-3.75" and 1-16" x 18" hole
Type	Recycled plastic
Material	200 mil. Polyethylene. These shall not be made of corrugated material.
Approved Supplier	Part Number
Rocky Mountain Template	Use description
Underground Supply	Use description

NOTE: Conduit spacer for 0-500 kVA, 3Ø transformer pad 5069778.

Electric Service Specifications	CONTRACTOR-SUPPLIED MATERIAL CONDUIT STUB-UP TEMPLATE 0-500 kVA, 3Ø TRANSFORMER	ISSUE DATE: 04/19/05
	11-34	REV DATE: 09/26/13
PROPRIETARY MATERIAL		APPROVAL: N. Sabaiah
		ES011-34.doc


SECTION 11: CONTRACTOR-SUPPLIED MATERIAL

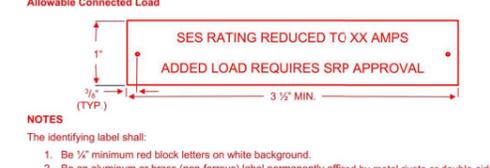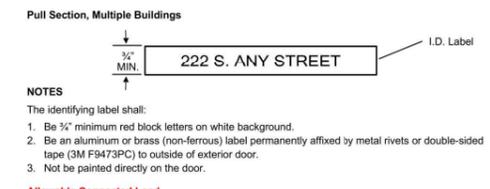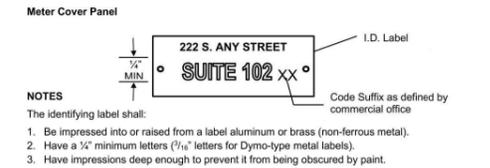

NOTE: Conduit spacer for 0-500 kVA, 3Ø transformer pad 5069778.

Electric Service Specifications	CONTRACTOR-SUPPLIED MATERIAL LABELING, SES	ISSUE DATE: 11/19/10
	11-51	REV DATE: 09/09/13
PROPRIETARY MATERIAL		APPROVAL: N. Sabaiah
		ES011-51.doc

SECTION 11: CONTRACTOR-SUPPLIED MATERIAL

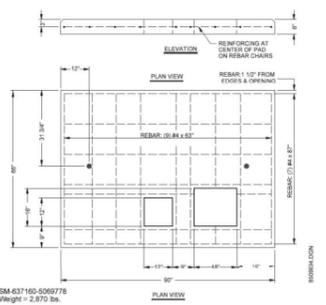

SRP Material Item No. 5069778	
Description	
Noun	Pad
Adjective	Transformer
Size	7.5' x 5.5'
Type	0-500 kVA
Style	Precast
Special Ref.	SM-637160
Material	Concrete
Approved Supplier	Part Number
Jensen Precast	Use Description
Oldcastle	Use Description
Olson Precast	Use Description

NOTE: 1. See referenced SM for construction specifications.

Electric Service Specifications	CONTRACTOR-SUPPLIED MATERIAL THREE-PHASE TRANSFORMER PADS 75-500 kVA	ISSUE DATE: 06/27/10
	11-54	REV DATE: 09/09/13
PROPRIETARY MATERIAL		APPROVAL: N. Sabaiah
		ES011-54.doc

CONTACTS	
DESIGN CONSULTANT:	JEREMY HUNT
OFFICE:	(602) 236-4858
MOBILE:	480-392-7966

PROJECT LEADER:	VICTOR CUEVAS
MOBILE:	602-376-5538
CONSTRUCTION CONSULTANT:	MARCEL KUNISKI
MOBILE:	480-793-0157
INSPECTIONS:	OFFICE: 602-236-0676

JOBNAME:	COP - FIRE STATION 74
ADDRESS/LOCATION:	19TH AVE AND CHANDLER BLVD, PHX
CONTACT:	VERONICA ALVAREZ
PHONE:	602-534-8136
BILLING ACCT NO.:	
FIS JO:	MAP 1/4 NE S 36 T 1S R 2E
40/ACRE:	ZB-36-01
COORDS:	11 15/16E - 5 1/5S
WAM WO:	T3567105
WAM VERSION:	
COST CENTER:	22640
ROUTING CODE:	DDY+8



