

MATCHLINE - SEE BELOW

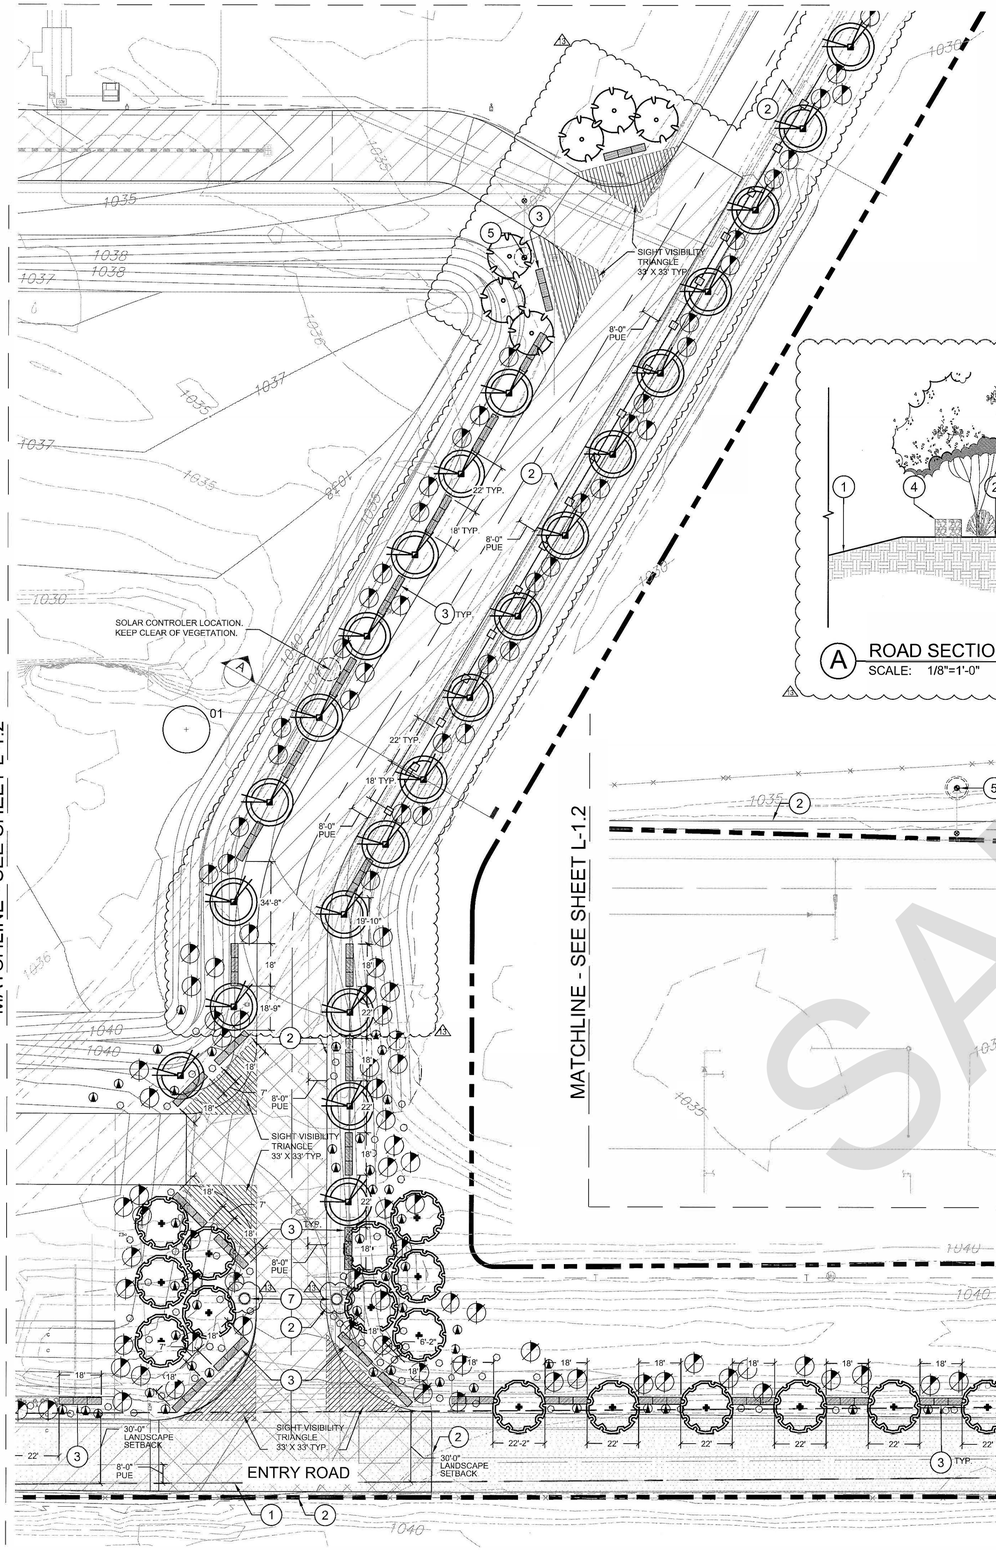

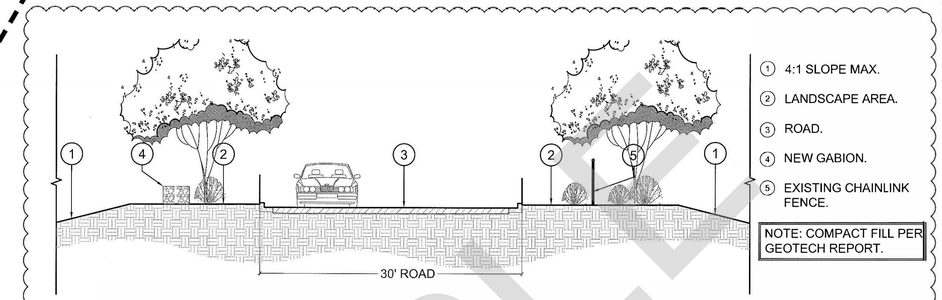

A ROAD SECTION/ELEVATION
SCALE: 1/8"=1'-0" ELEV-48

PLANT LEGEND

SYM.	BOTANICAL NAME / COMMON NAME	SIZE	MIN. CAL HT X W	QTY.
	TREES			
	PARKINSONIA FLORIDA BLUE PALO VERDE	36" BOX MULTI	2" CAL. 10'H X 6'W	6
	FRAXINUS VELUTINA 'FAN TEX' FAN-TEX ASH	24" BOX	1.5" CAL. 4'H X 1.5'W	55
	PROSOPIS X PHOENIX HYBRID MESQUITE	36" BOX MULTI	2.5" CAL. 10'H X 8'W	28
	SHRUBS			
	LARREA TRIDENTATA CREOSOTE	5 GAL		300
	CALLIANDRA CALIFORNICA FAIRY DUSTER	5 GAL		96
	ENCELIA FARINOSA BRITTLEBUSH	1 GAL		441
	TOPDRESS / DUST CONTROL ORGANIC MULCH TOP DRESSING, PROVIDED ONSITE BY OWNER, IN ALL PLANTING AREAS. 3" DEPTH MIN.			2.5 AC

PAVING LEGEND

- ASPHALT. SEE CIVIL.
- ASPHALT MILLINGS. SEE CIVIL.
- 7" PCCP. SEE CIVIL.
- 9" PCCP W/ SACRIFICIAL TOPPING SLAB. SEE CIVIL.
- 9" PCCP. SEE CIVIL.
- HDPE LINER. SEE CIVIL.
- STRUCTURAL SECTION. SEE CIVIL.
- PALLIATIVE DUST COVER. SEE CIVIL.
- GUNITE. SEE CIVIL.

BOULDER SCHEDULE

SYM.	BOULDER	SIZE	QTY.
A	LARGE SURFACE SELECT GRANITE BOULDER	3' X 4' X 5'	30
B	MEDIUM SURFACE SELECT GRANITE BOULDER	3' X 3' X 3'	56
C	SMALL SURFACE SELECT GRANITE BOULDER	2' X 2' X 3'	56

LANDSCAPE KEYNOTES


1. PROPERTY LINE / R.O.W.
2. LIMIT OF CONSTRUCTION / SCOPE OF WORK
3. GABION WALL AS SUPPLIED BY HILFIKER RETAINING WALLS WALL HEIGHT 2'-0". SEE DETAIL 4/L2.1
4. JUTE NETTING, EROSION CONTROL. SEE DETAIL 3/L2.1
5. FIRE HYDRANT. 3' CLEARANCE PROVIDED.
6. 12' HIGH RETAINING WALL.SEE STRUCTURAL.
7. RE-PURPOSED CONCRETE PIPE.

NOTE

1. OVERHEAD POWERLINES LOCATED OUTSIDE THE SCOPE OF WORK.
2. ALL PERIMETER GRADES ADJACENT TO STREETS AND RIGHT OF WAY, SHALL PREVENT NUISANCE WATER FROM LEAVING THE SITE. SEE CIVIL GRADING & DRAINAGE PLANS.

SAMPLE

AS-BUILT

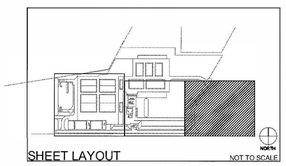

NORTH SCALE: 30 60 1" = 30'-0"

CALL TWO WORKING DAYS BEFORE YOU DIG 263-100 1-800-STAKE-IT (OUTSIDE MARICOPA COUNTY)

KIVA#: 09-3296; SDEV#: 0900363; CCPR#: 1601852; APN#: 105-42-002B; ENVR#: 100024; H#:10021; QS#: 6-22; ZONING: A-1; ZONING CASE#: Z-SP-24-01/Z-SP-28-07

Arrington Watkins Architects
5240 North 16th Street, Suite 101
Phoenix, Arizona 85016
Telephone: (602) 279-4373
Fax: (602) 279-9110
A Limited Liability Company
© Copyright 2014

REGISTERED LANDSCAPE ARCHITECT CERTIFICATE NO. 22612 KRISTINA J. FLOOR PHOENIX, ARIZONA U.S.A.
02.10.17
EXPIRES: 12/31/17

FLOOR associates
1425 N. First Street Second Floor Phoenix, AZ 85004
602.462.1425 P
602.462.1427 F
floorassociates.com

CITY OF PHOENIX
RESOURCE INNOVATION CAMPUS COMPOST FACILITY
AT 27th AVE LANDFILL COMPLEX
3060 SOUTH 27TH AVENUE
PHOENIX, ARIZONA 85009

NO.	REVISION	DATE
2	ASI-I006	12/09/2016
3	ASI-I012	2/10/2017


PROJECT NO.:	2014.057
DATE:	02/10/2017
DESIGNED BY:	IC / MT
DRAWN BY:	IC / MT
APPROVED BY:	CB


SHEET TITLE:
ENLARGED LANDSCAPE PLAN

SHEET NUMBER:
L-1.3 04 OF 09

LANDSCAPE SUBMITTAL

M1 | EXTERIOR ELEVATION LOOKING EAST
Scale: 3/4" = 1'-0"

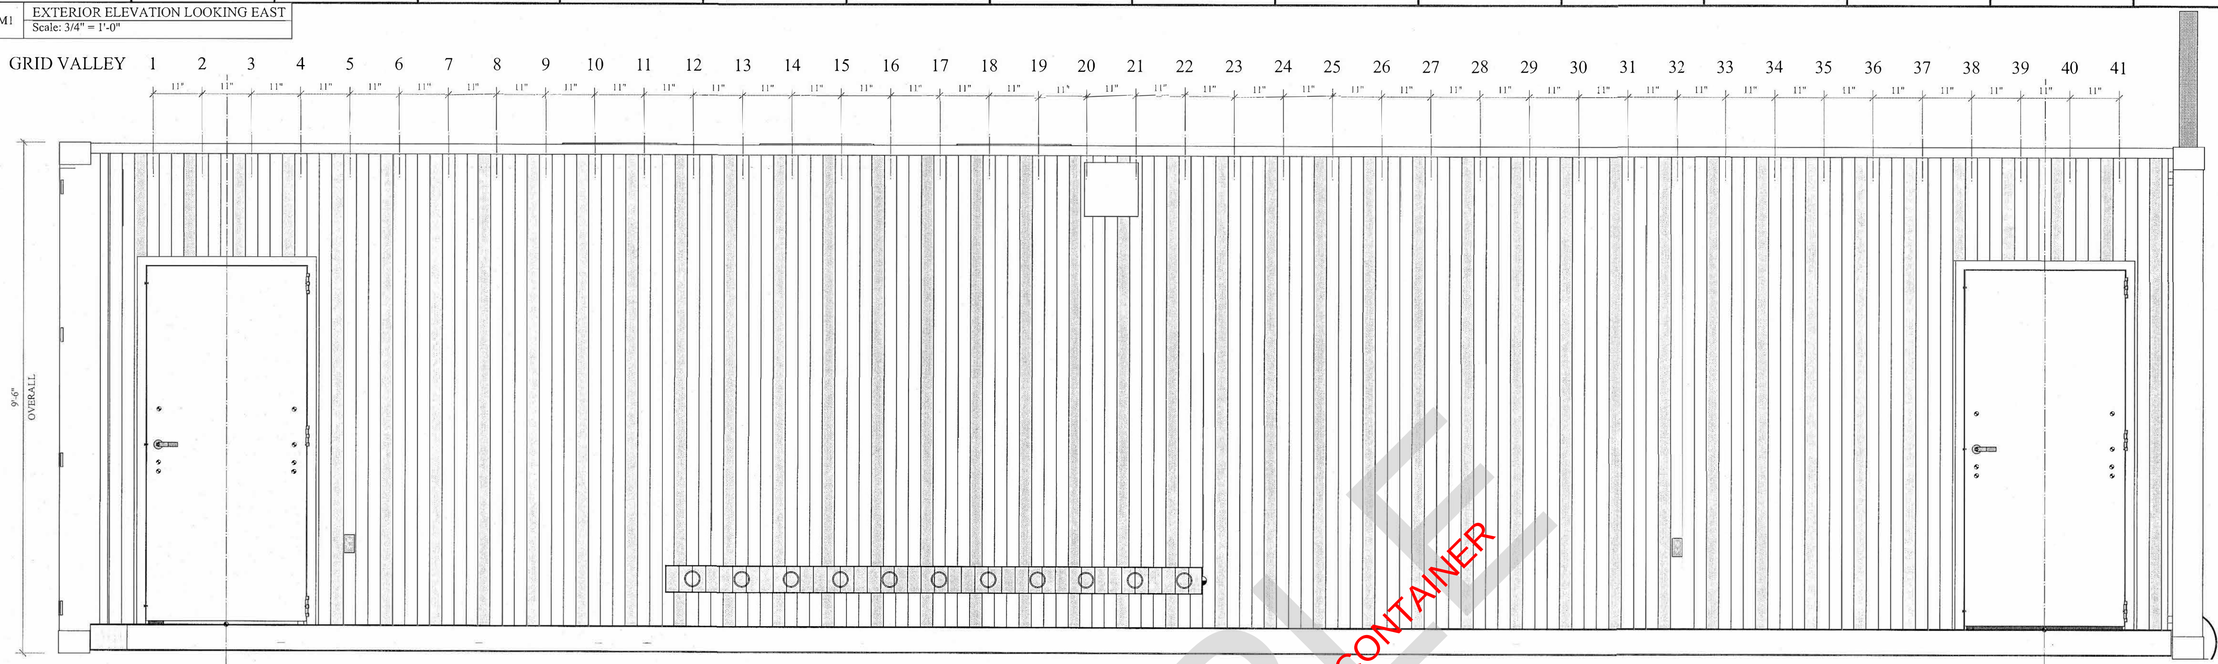

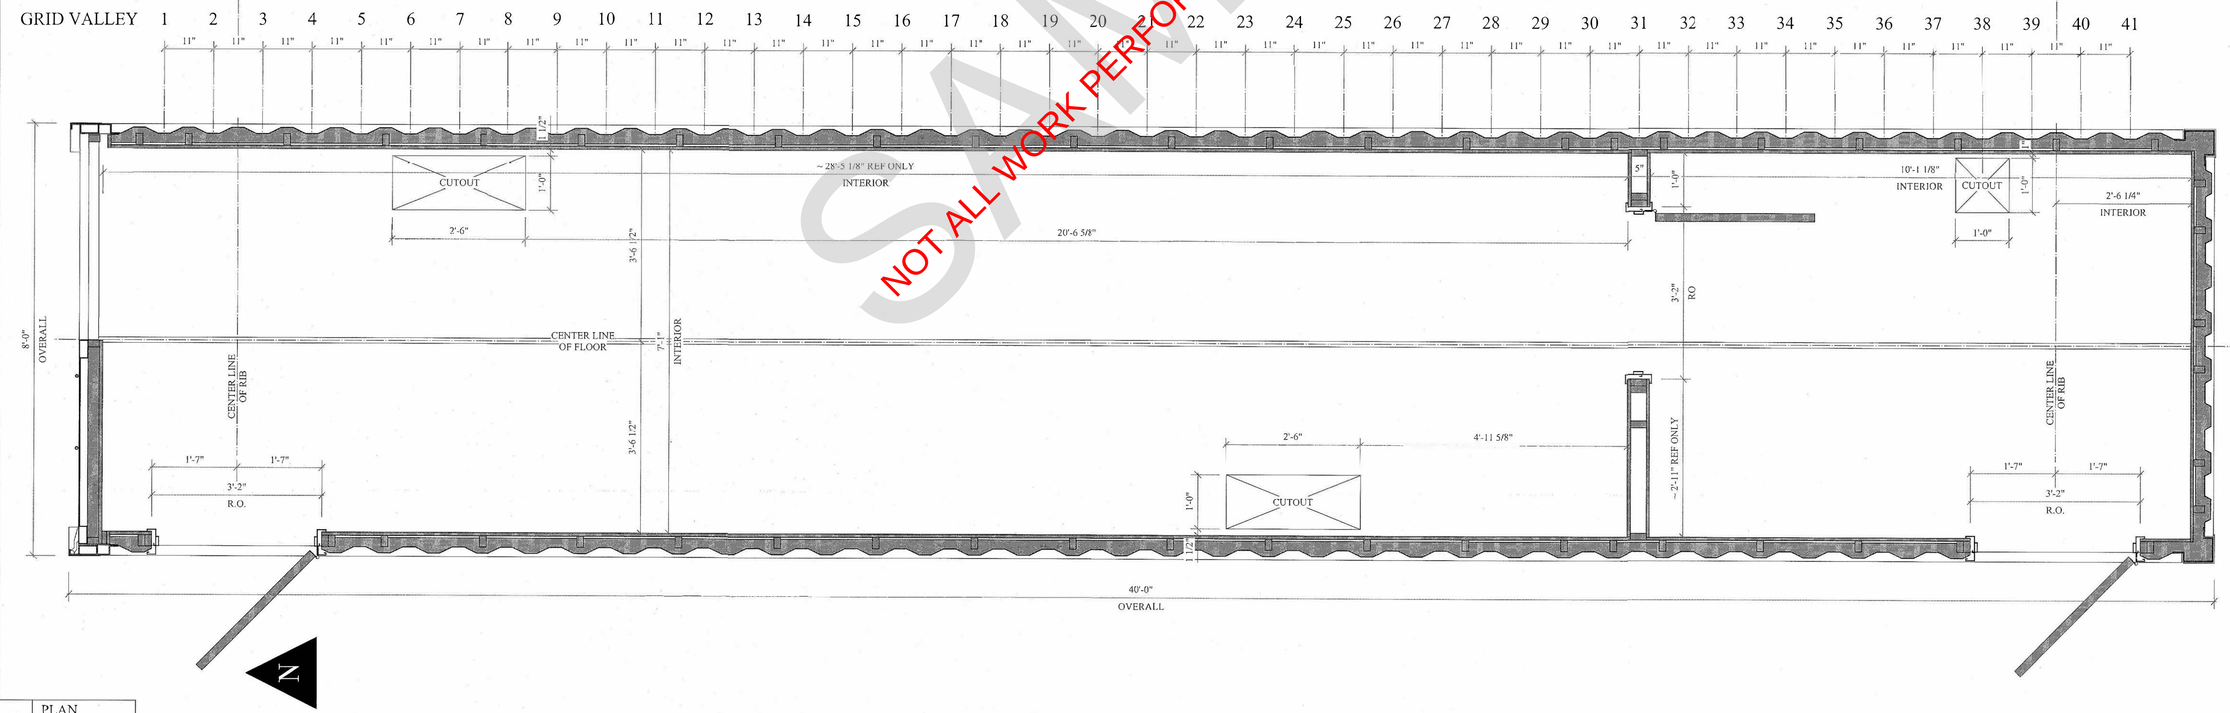

A1 | PLAN
Scale: 3/4" = 1'-0"

SAMPLE
NOT ALL WORK PERFORMED IN THIS CONTAINER

Green Mountain Technologies
Commercial Composting Solutions

PROPRIETARY INFORMATION: THIS DRAWING IS THE PROPERTY OF GREEN MOUNTAIN TECHNOLOGIES & SHALL NOT BE USED, COPIED, OR MADE AVAILABLE IN WHOLE OR IN PART, NOR SHALL THE CONTENTS BE REVEALED IN ANY MANNER TO ANYONE UNLESS WRITTEN PERMISSION IS OBTAINED FROM GREEN MOUNTAIN TECHNOLOGIES

Review & Comment
Date: 2017, Jan 27
Time: 8:36:56 AM
File name: CoP TAP 40ft Container.vwx

No.	Date	Issue Notes

Designed By	JPG & MBB
Drawn By	MTW
Checked By	MBB
Reviewed By	MBB
Submitted By	GMT
Project Manager	-
Date	2016.11.03
Revision	Revision
Project ID	-
Drawing Code	-
CAD File Name	CoP ASZ.vwx
Plot Date	00/00/00

Design Firm: GREEN MOUNTAIN TECHNOLOGIES
5350 McDonald Ave NE
Bainbridge Island WA, 98110

Consultant:

Project Title: CITY OF PHOENIX
27th AVE
TRANSFER STATION

Drawing Title: PLAN FRAMING & WEST ELEVATION


Scale: Sheet Scale

Drawing No.: Con40Hi-11

— of —
Total Sheets

M1 | INTERIOR ELEVATION LOOKING EAST
Scale: 3/4" = 1'-0"

A1 | PLAN
Scale: 3/4" = 1'-0"

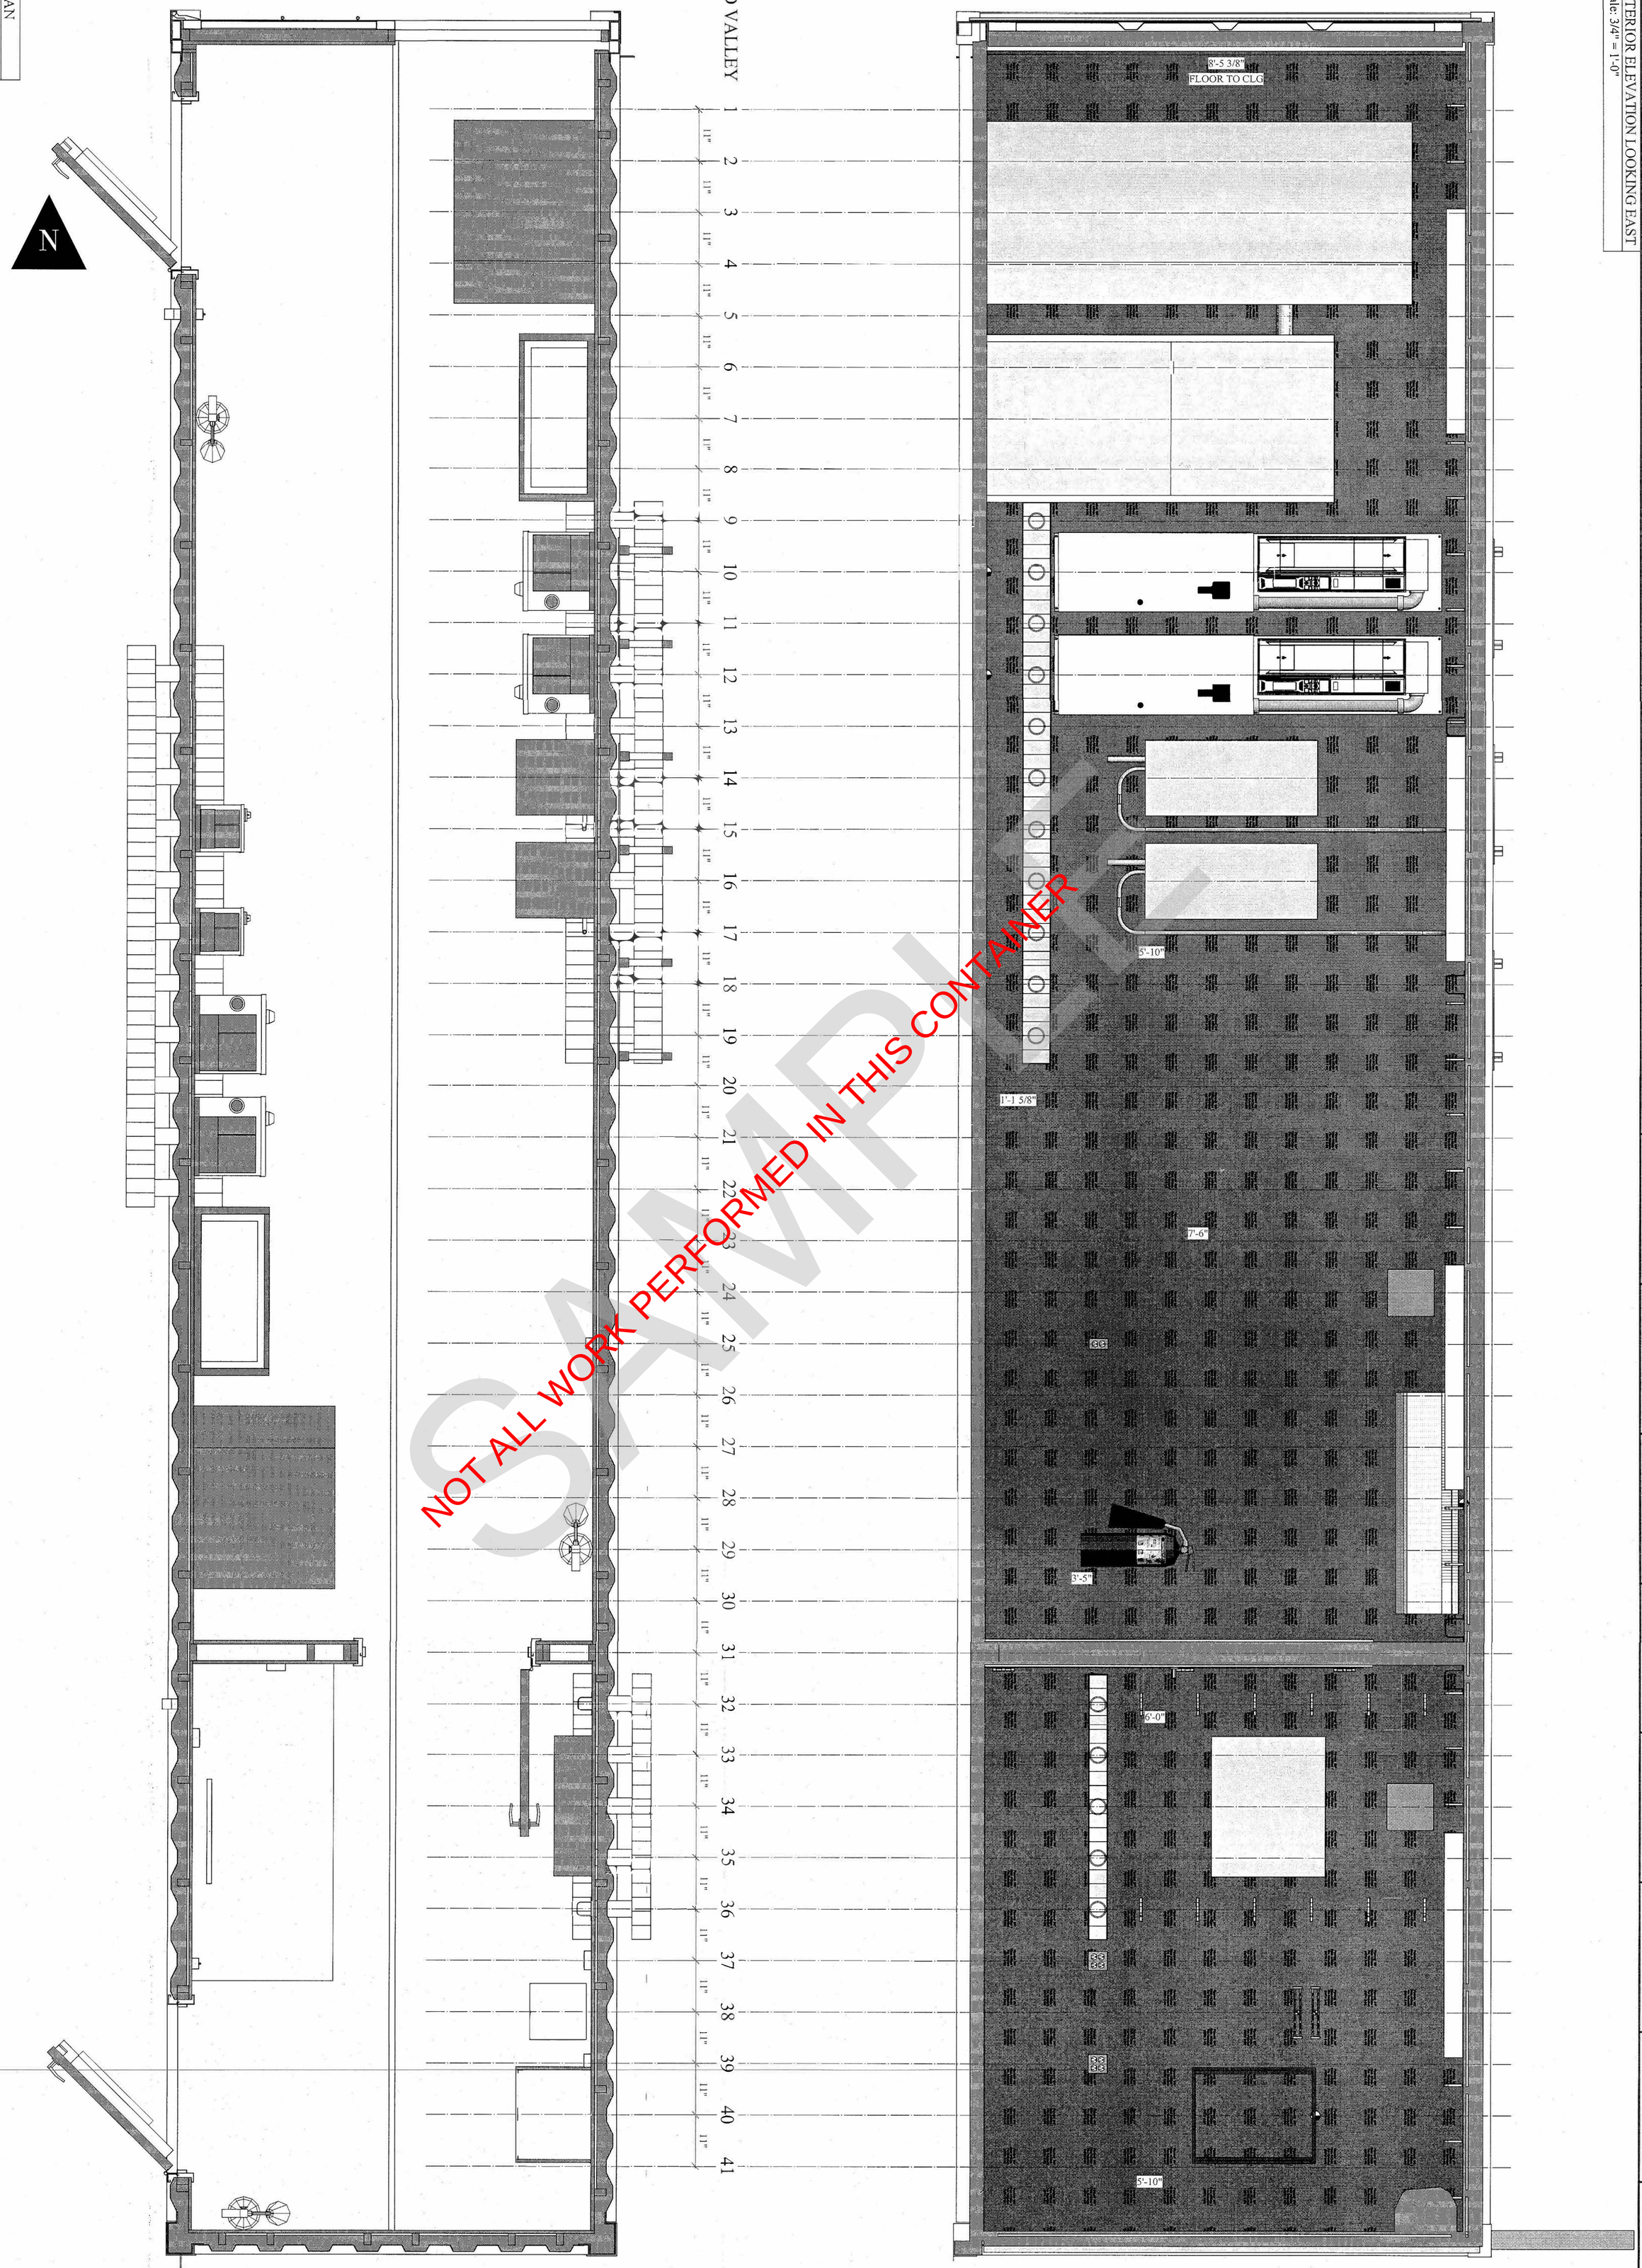

SAMPLE
NOT ALL WORK PERFORMED IN THIS CONTAINER

Drawing No. Con40Hi-13	Project Title: CITY OF PHOENIX, 27th AVE TRANSFER STATION	Design Firm: GREEN MOUNTAIN TECHNOLOGIES, 5350 McDonald Ave NE, Bainbridge Island WA 98110	Designed By: JPG & MBB	Date: 2016.11.03	Review & Comment
Scale: Sheet Scale			Drawn By: MTW	Revision: Revision	Date: 2017, Jan 27
Total Sheets: ___ of ___	Drawing Title: PLAN & EAST INTERIOR ELEVATION	Consultant: - - -	Checked By: MBB	Project ID: -	Time: 8:37:00 AM
			Reviewed By: MBB	Drawing Code: Drawing Code	File name: CoP TAP 40ft Container.vwx
			Submitted By: GMT	CAD File Name: CoP ASP.vwx	
			Project Manager: -	Plot Date: 00/00/00	


No.	Date	Issue Notes

Green Mountain Technologies
Commercial Composting Solutions

PROPRIETARY INFORMATION: THIS DRAWING IS THE PROPERTY OF GREEN MOUNTAIN TECHNOLOGIES & SHALL NOT BE USED, COPIED OR REPRODUCED IN WHOLE OR IN PART, NOR SHALL THE CONTENTS BE REVEALED IN ANY MANNER TO ANYONE UNLESS WRITTEN PERMISSION IS OBTAINED FROM GREEN MOUNTAIN TECHNOLOGIES.

M1 | INTERIOR ELEVATION LOOKING WEST
Scale: 3/4" = 1'-0"

A1 | PLAN
Scale: 3/4" = 1'-0"

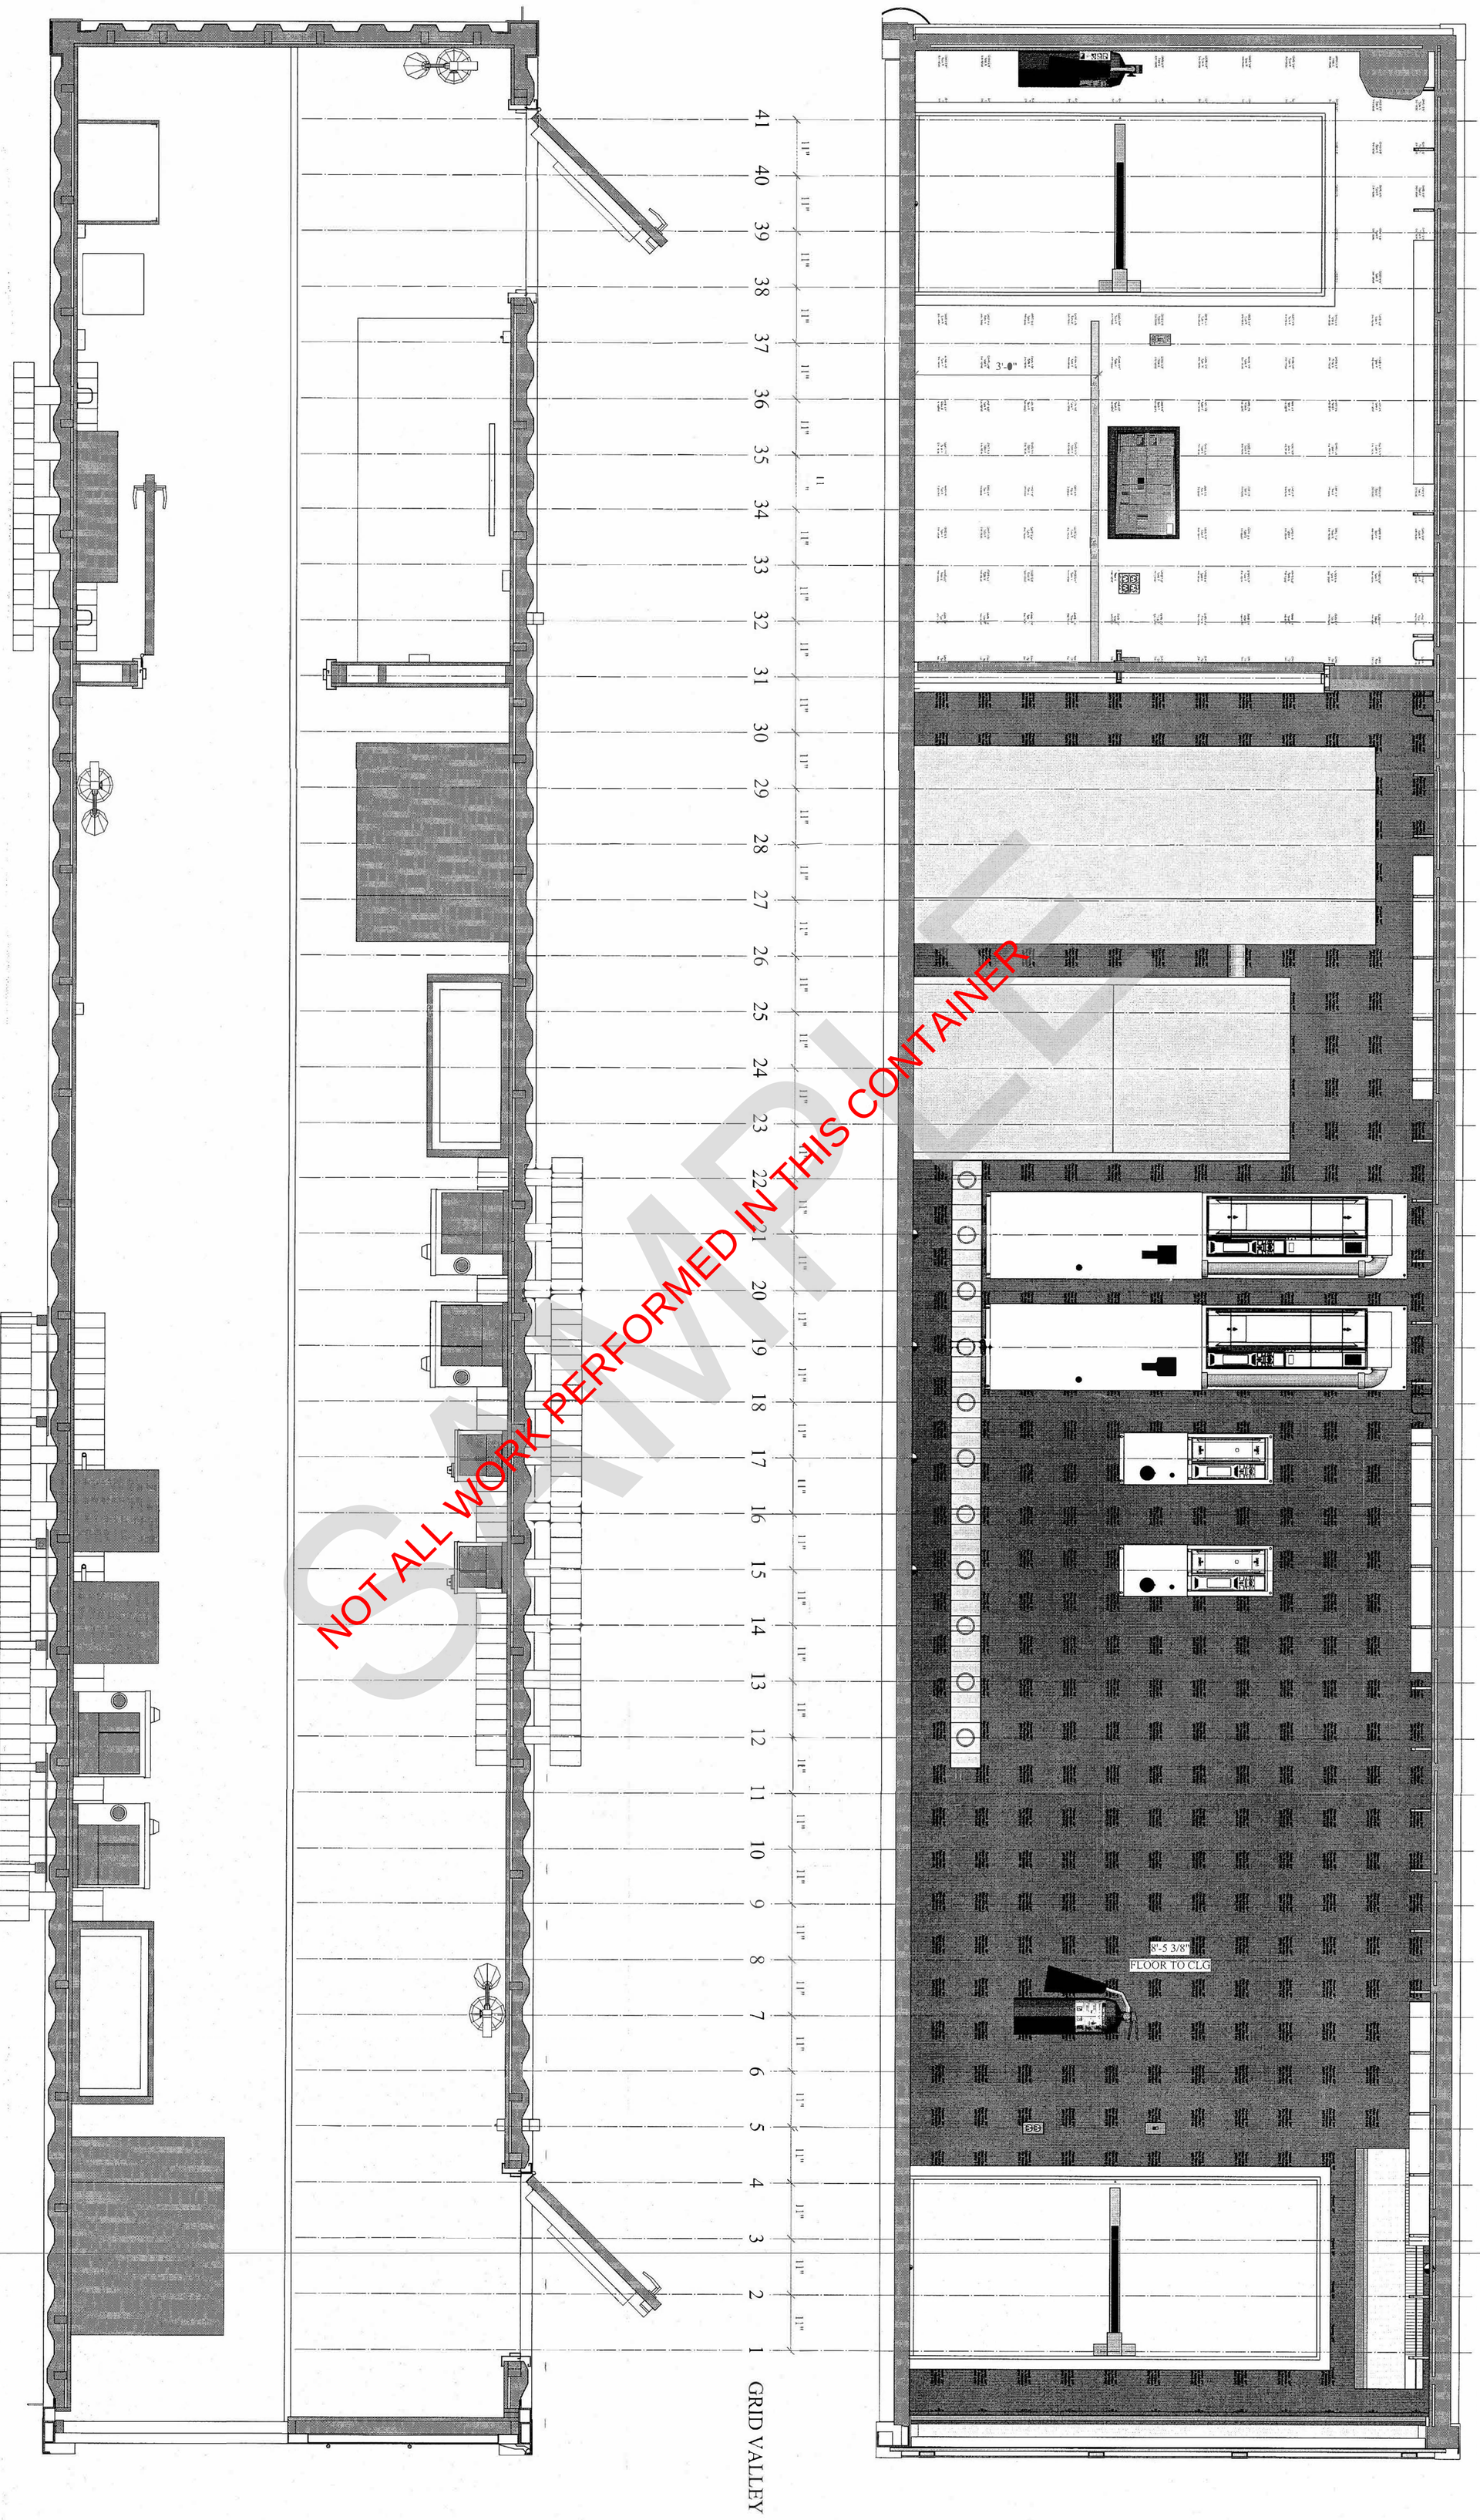

NOT ALL WORK PERFORMED IN THIS CONTAINER
SAMPLE

Project Title	CITY OF PHOENIX 27th AVE TRANSFER STATION
Drawing Title	PLAN & WEST INTERIOR ELEVATION
Design Firm	GREEN MOUNTAIN TECHNOLOGIES 5350 McDonald Ave NE Bainbridge Island WA 98110
Consultant	
Designed By	JPG & MBB
Drawn By	MTW
Checked By	MBB
Reviewed By	MBB
Submitted By	GMT
Project Manager	-
Date	2016.11.03
Revision	Revision
Project ID	-
Drawing Code	Drawing Code
CAD File Name	CoP ASP.vwx
Plot Date	00/00/00
Drawing No.	Con40Hi-15
Total Sheets	____ of ____
Scale	Sheet Scale


Review & Comment


Date: **2017, Jan 27**
Time: **8:37:04 AM**
File name: **CoP TAP 40ft Container.vwx**


No.	Date	Issue Notes


Green Mountain Technologies
Commercial Composting Solutions


PROPRIETARY INFORMATION: THIS DRAWING IS THE PROPERTY OF GREEN MOUNTAIN TECHNOLOGIES & SHALL NOT BE USED, COPIED OR REPRODUCED IN WHOLE OR IN PART, NOR SHALL THE CONTENTS BE REVEALED IN ANY MANNER TO ANYONE UNLESS WRITTEN PERMISSION IS OBTAINED FROM GREEN MOUNTAIN TECHNOLOGIES.

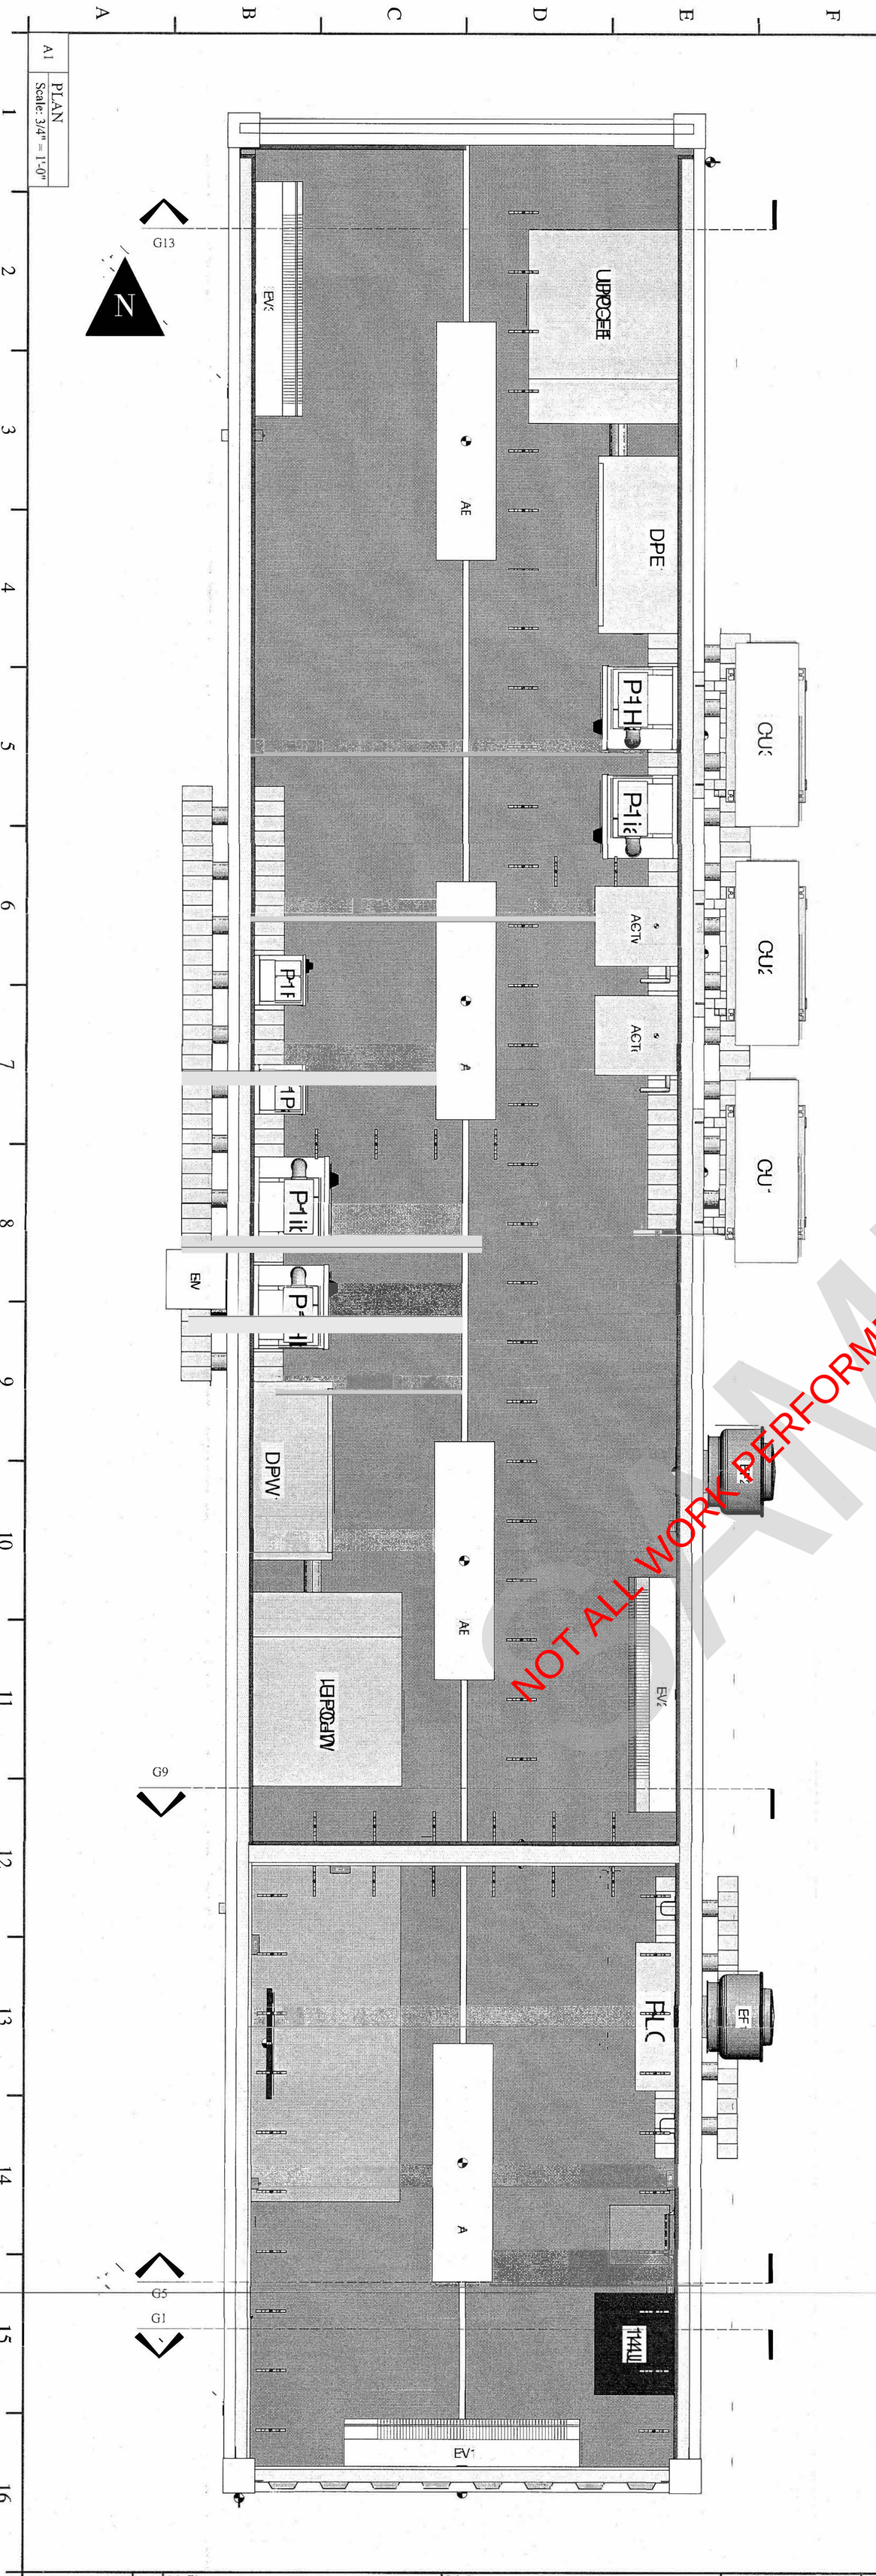

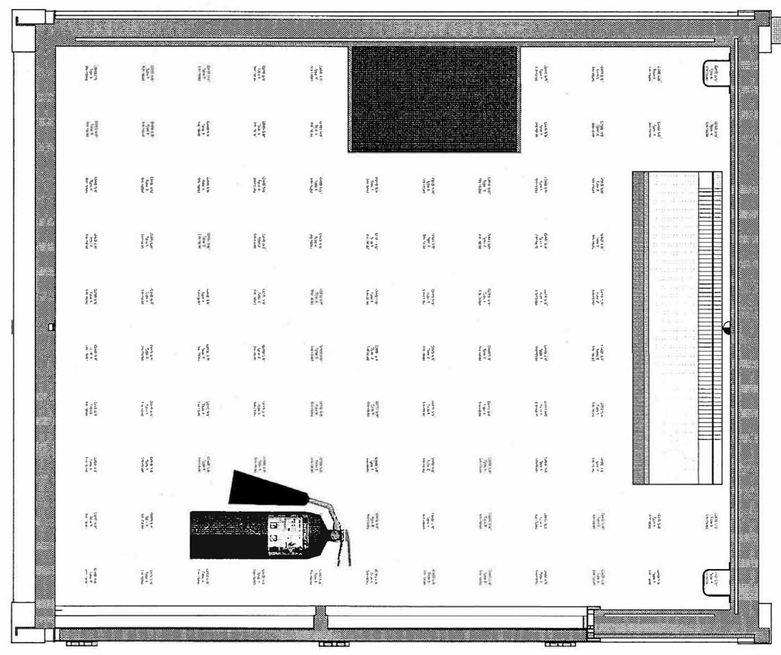
G1 INTERIOR ELEVATION LOOKING SOUTH
Scale: 3/4" = 1'-0"

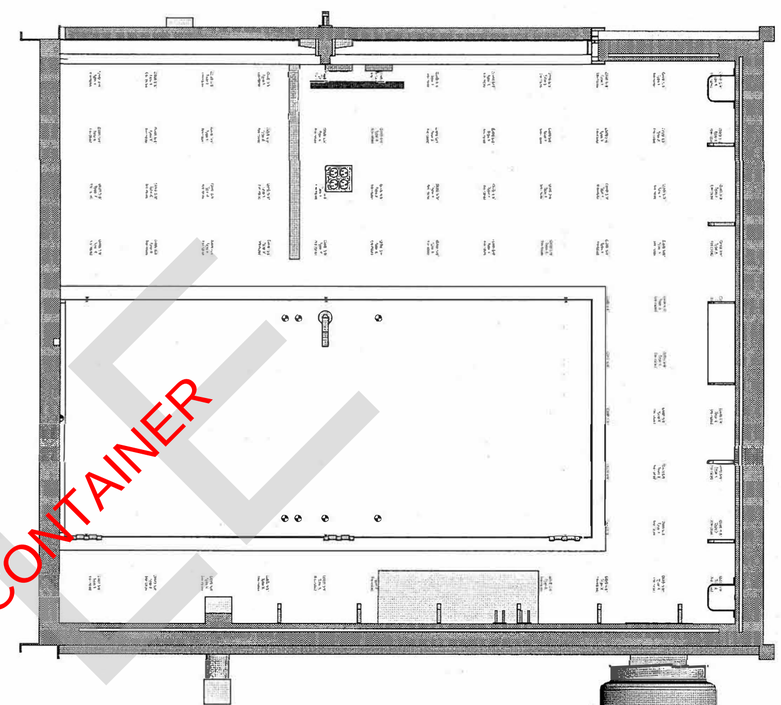
G5 INTERIOR ELEVATION LOOKING NORTH
Scale: 3/4" = 1'-0"

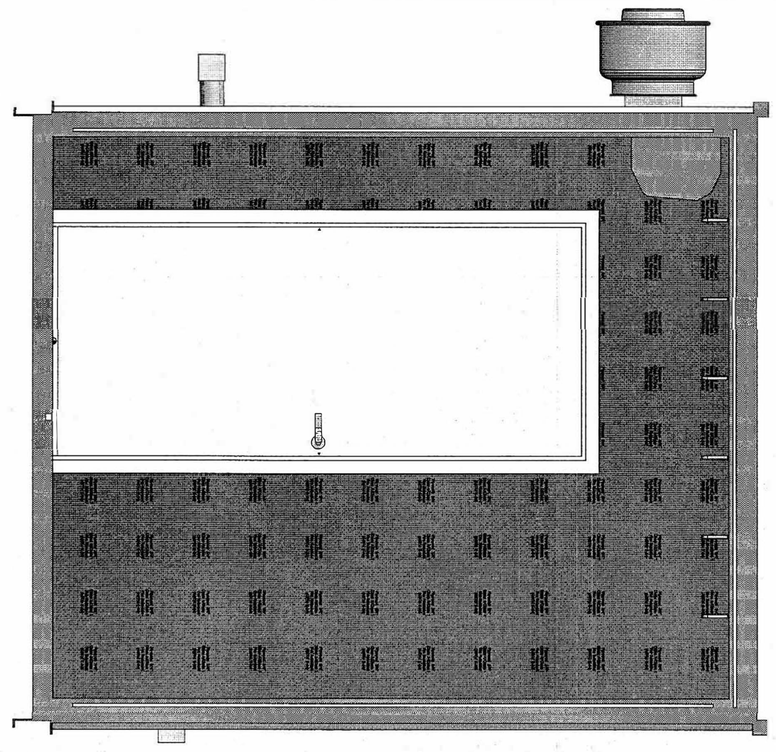
G9 INTERIOR ELEVATION LOOKING SOUTH
Scale: 3/4" = 1'-0"

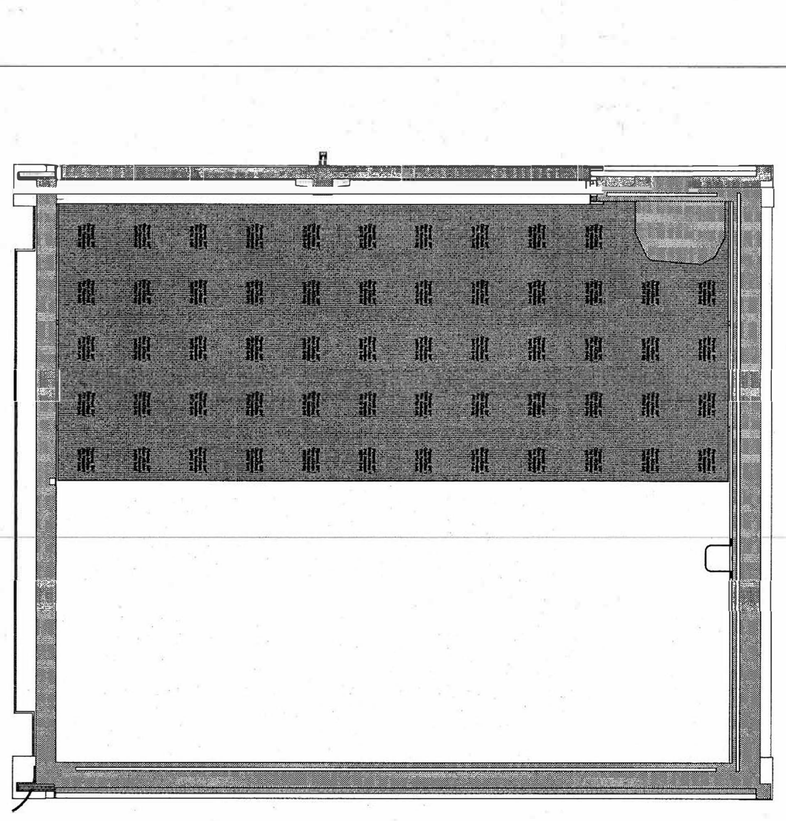
G13 INTERIOR ELEVATION LOOKING NORTH
Scale: 3/4" = 1'-0"

NOT ALL WORK PERFORMED IN THIS CONTAINER

Drawing No. Con40Hi-17 — of — Total Sheets

Scale: Sheet Scale

Project Title: CITY OF PHOENIX
27th AVE
TRANSFER STATION

Drawing Title: PLAN W/ LABLES
N & S INTERIOR ELEVATION

Design Firm: GREEN MOUNTAIN TECHNOLOGIES
5350 McDonald Ave NE
Bainbridge Island WA 98110

Consultant: - - -

Designed By: JPG & MBB	Date: 2016.11.03
Drawn By: MTW	Revision: Revision
Checked By: MBB	Project ID: -
Reviewed By: MBB	Drawing Code: Drawing Code
Submitted By: GMT	CAD File Name: CoP ASP.vwx
Project Manager: -	Plot Date: 00/00/00


Review & Comment

Date: **2017, Jan 27**
Time: **8:37:08 AM**
File name: **CoP TAP 40ft Container.vwx**


No.	Date	Issue Notes

Green Mountain Technologies
Commercial Composting Solutions

PROPRIETARY INFORMATION: THIS DRAWING IS THE PROPERTY OF GREEN MOUNTAIN TECHNOLOGIES & SHALL NOT BE USED, COPIED OR REPRODUCED IN WHOLE OR IN PART, NOR SHALL THE CONTENTS BE REVEALED IN ANY MANNER TO ANYONE UNLESS WRITTEN PERMISSION IS OBTAINED FROM GREEN MOUNTAIN TECHNOLOGIES.

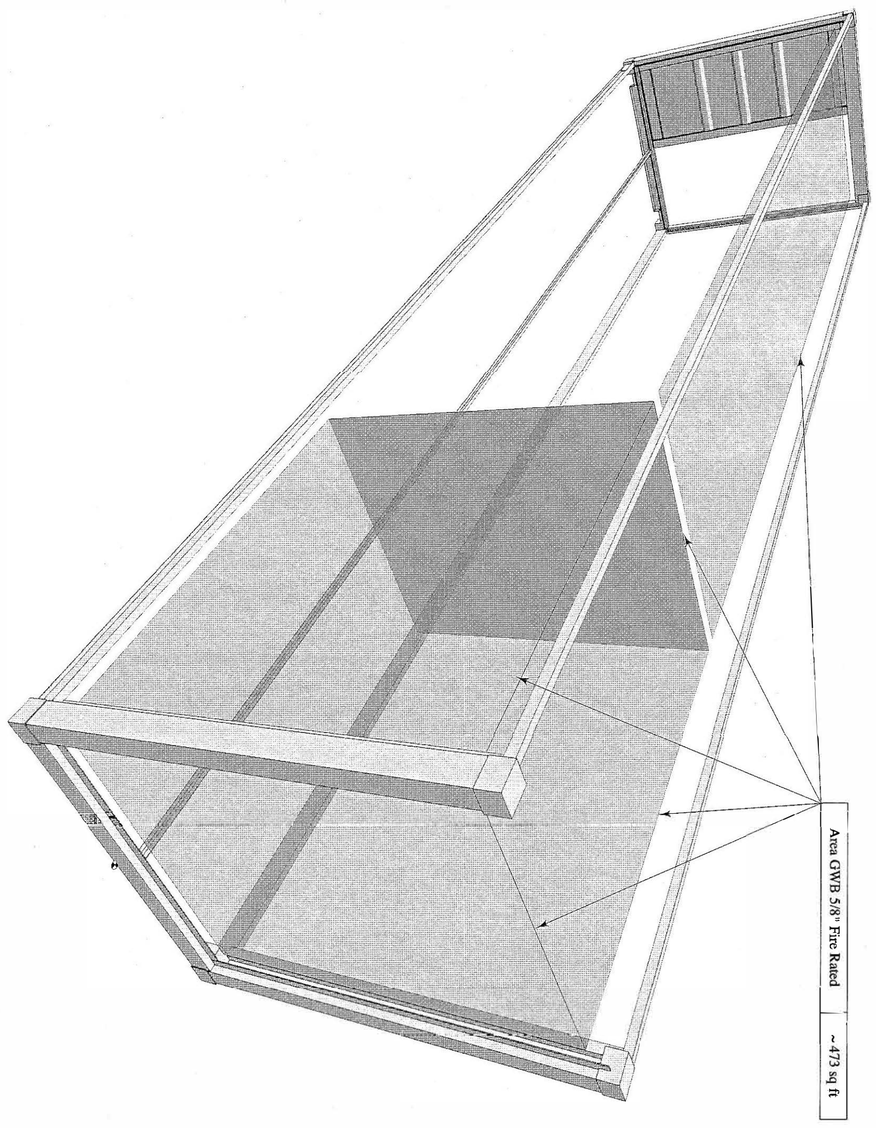


A1 | PERSPECTIVE - SHEETS
Scale: 1 1/2" = 1'-0"

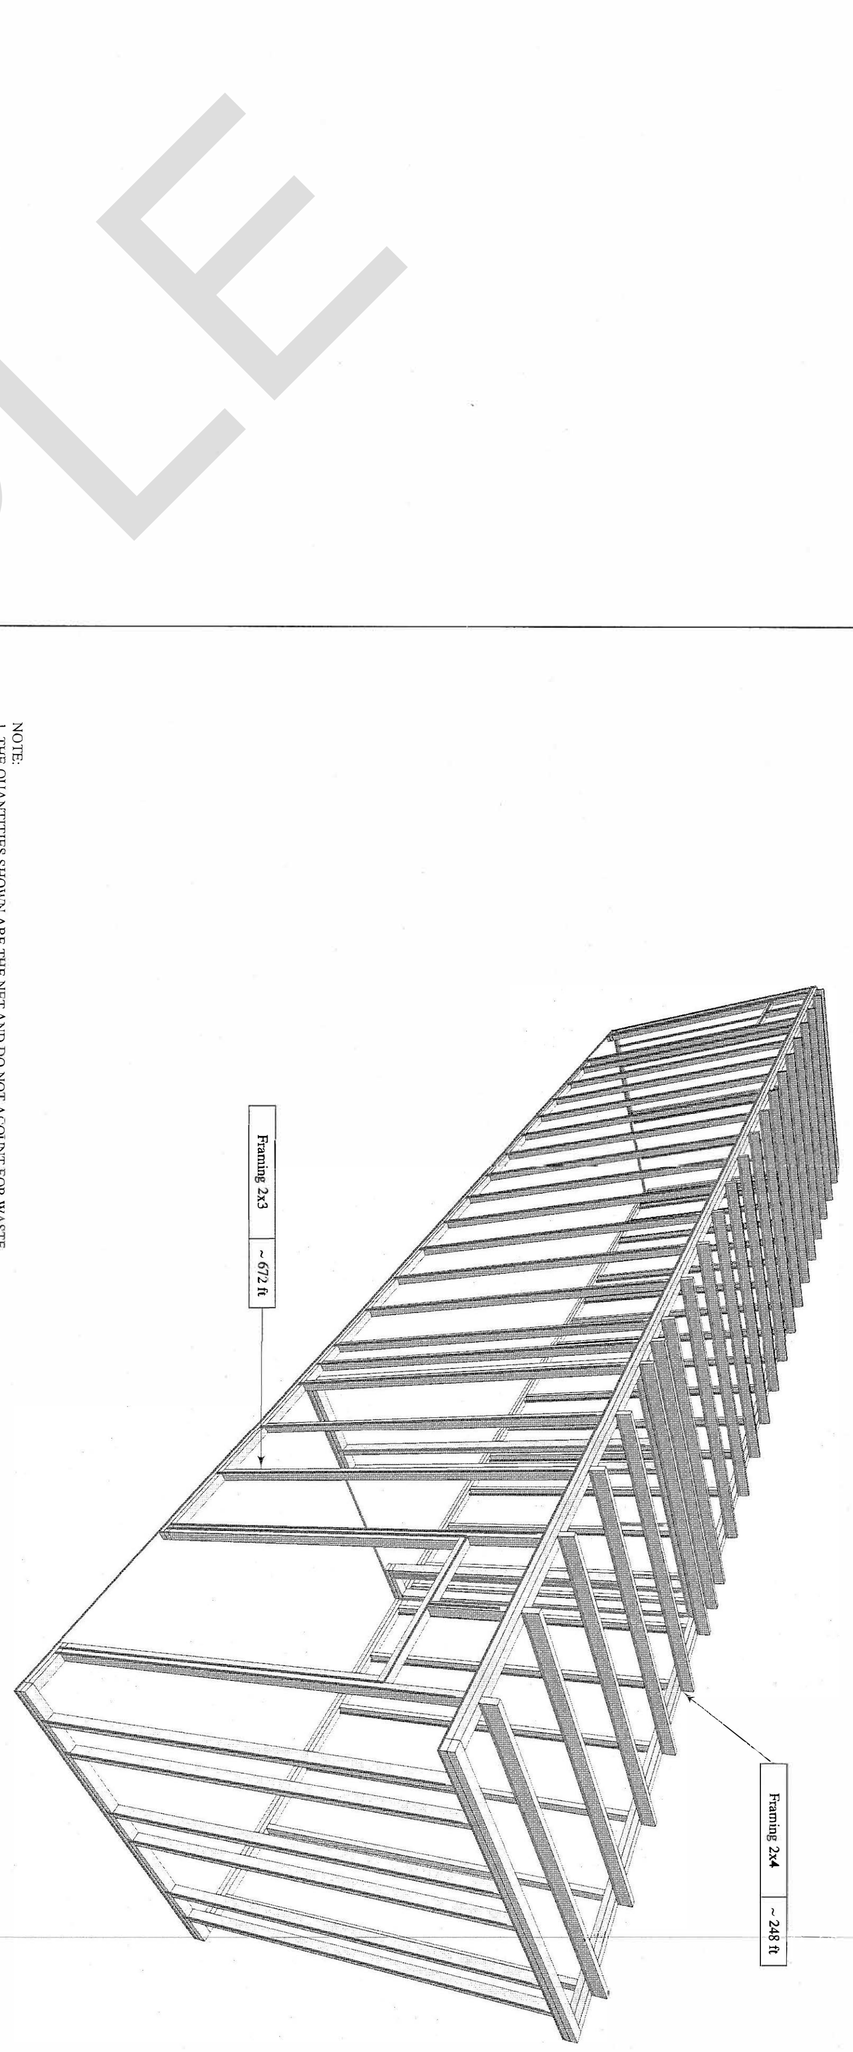

G9 | PERSPECTIVE - FRAMING
Scale: 1 1/2" = 1'-0"

NOTE:
1. THE QUANTITIES SHOWN ARE THE NET AND DO NOT ACOUNT FOR WASTE. ADD 15% FOR WASTE??

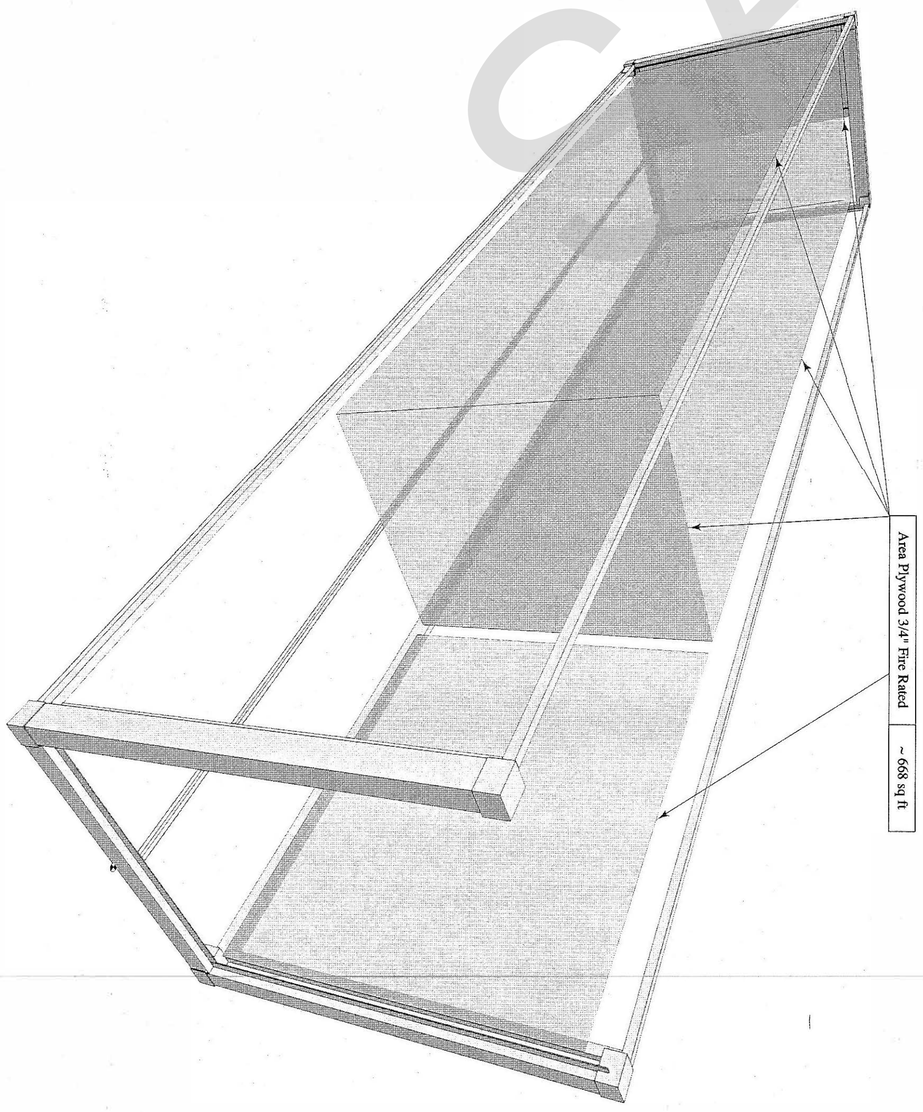

A9 | PERSPECTIVE - SHEETS
Scale: 1 1/2" = 1'-0"

SAMPLE

Drawing No. Con40Hi-05 — of — Total Sheets	Scale: Sheet Scale	Project Title: CITY OF PHOENIX 27th AVE TRANSFER STATION	Design Firm: GREEN MOUNTAIN TECHNOLOGIES 5350 McDonald Ave NE Bainbridge Island WA 98110
		Drawing Title: BILL OF MATERIALS	Consultant: - - -


Designed By: JPG & MBB	Date: 2016.11.03
Drawn By: MTW	Revision: Revision
Checked By: MBB	Project ID: -
Reviewed By: MBB	Drawing Code: Drawing Code
Submitted By: GMT	CAD File Name: CoP ASP.vwx
Project Manager: -	Plot Date: 00/00/00

Review & Comment
Date: 2017, Jan 27
Time: 8:36:51 AM
File name: CoP TAP 40ft Container.vwx


No.	Date	Issue Notes

Green Mountain Technologies
Commercial Composting Solutions


PROPRIETARY INFORMATION: THIS DRAWING IS THE PROPERTY OF GREEN MOUNTAIN TECHNOLOGIES & SHALL NOT BE USED, COPIED OR REPRODUCED IN WHOLE OR IN PART, NOR SHALL THE CONTENTS BE REVEALED IN ANY MANNER TO ANYONE UNLESS WRITTEN PERMISSION IS OBTAINED FROM GREEN MOUNTAIN TECHNOLOGIES.

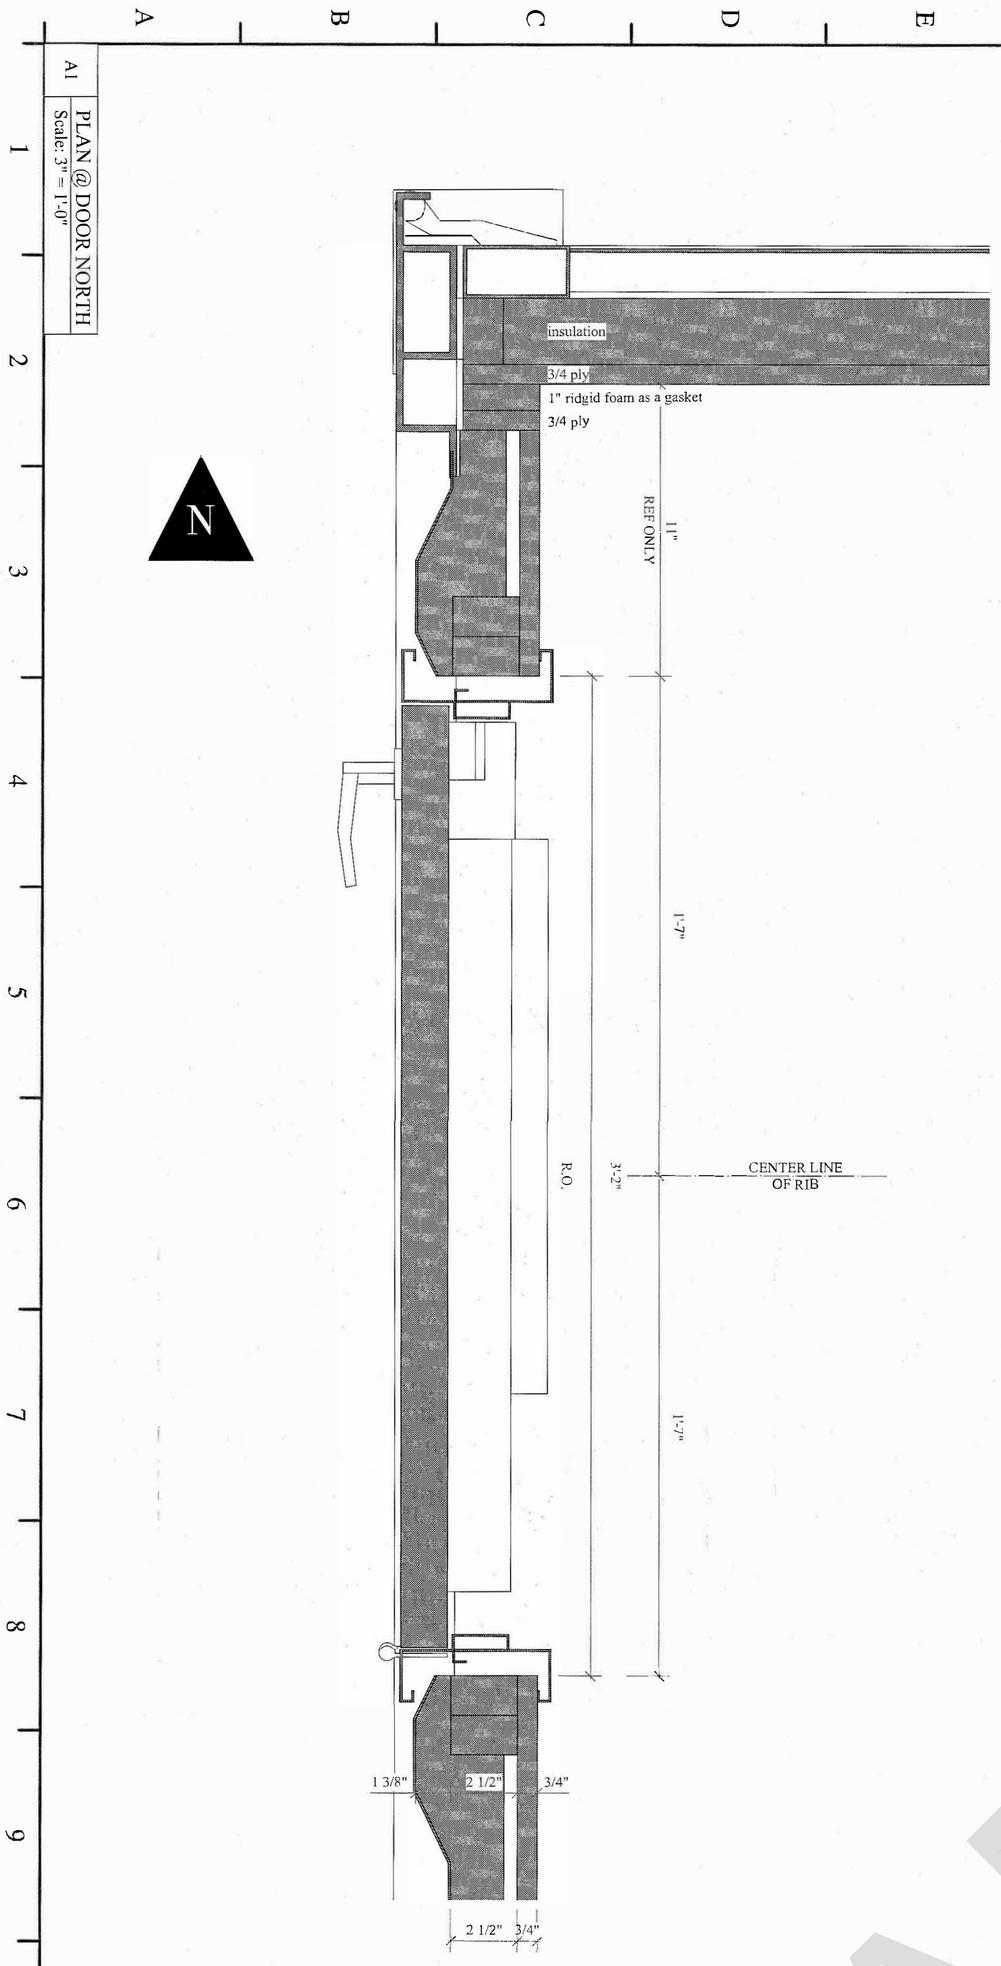


A1 PLAN @ DOOR NORTH
Scale: 3" = 1'-0"

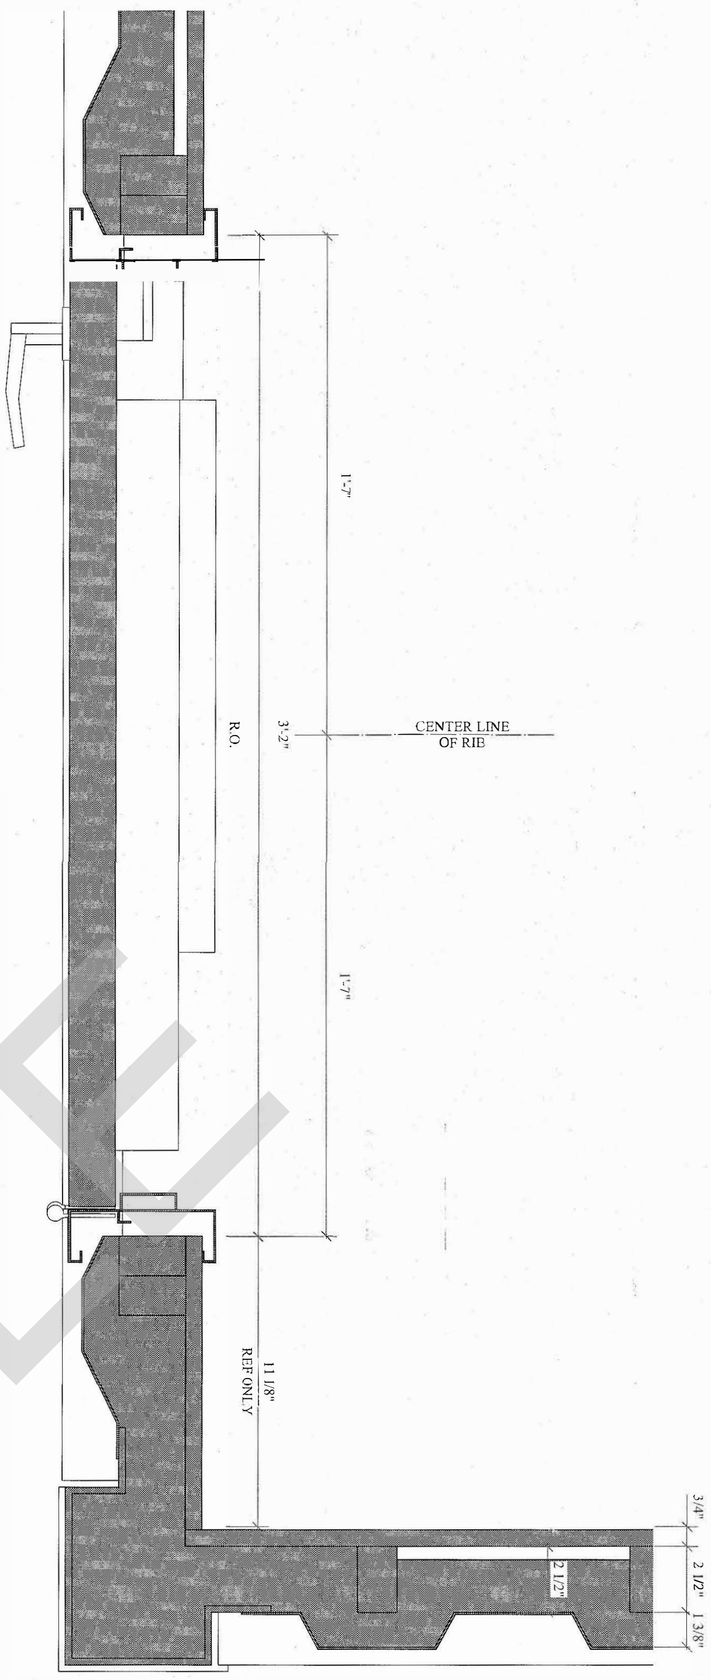

G1 PLAN @ DOOR SOUTH
Scale: 3" = 1'-0"

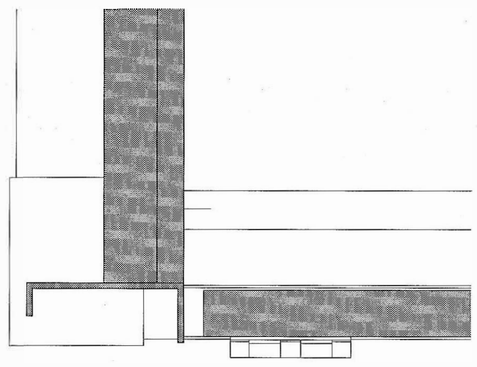

A11 SECTION @ DOOR SILL
Scale: 3" = 1'-0"

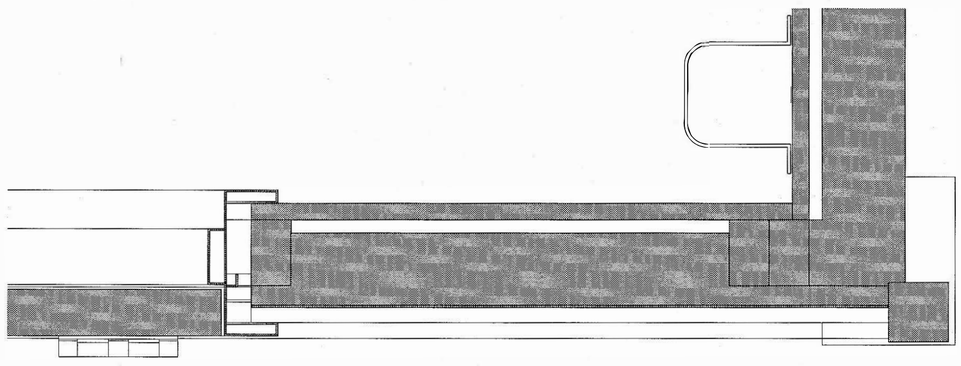

G11 SECTION @ DOOR HEADER
Scale: 3" = 1'-0"

SAMPLE


Drawing No. Con40Hi-21	Project Title: CITY OF PHOENIX, 27th AVE TRANSFER STATION	Design Firm: GREEN MOUNTAIN TECHNOLOGIES, 5350 McDonald Ave NE, Bainbridge Island WA 98110	Designed By: JPG & MBB	Date: 2016.11.03	Review & Comment
Total Sheets: —— of ——	Drawing Title: DOOR DETAILS JAMBS, HEADER & SILL	Consultant: - - -	Drawn By: MTW	Revision: Revision	Date: 2017, Jan 27
Scale: Sheet Scale			Checked By: MBB	Project ID: -	Time: 8:37:12 AM
			Reviewed By: MBB	Drawing Code: Drawing Code	File name: CoP TAP 40ft Container.vwx
			Submitted By: GMT	CAD File Name: CoP ASP.vwx	
			Project Manager: -	Plot Date: 00/00/00	

No.	Date	Issue Notes

Green Mountain Technologies
Commercial Composting Solutions

PROPRIETARY INFORMATION: THIS DRAWING IS THE PROPERTY OF GREEN MOUNTAIN TECHNOLOGIES & SHALL NOT BE USED, COPIED OR REPRODUCED IN WHOLE OR IN PART, NOR SHALL THE CONTENTS BE REVEALED IN ANY MANNER TO ANYONE UNLESS WRITTEN PERMISSION IS OBTAINED FROM GREEN MOUNTAIN TECHNOLOGIES.

SAMPLE

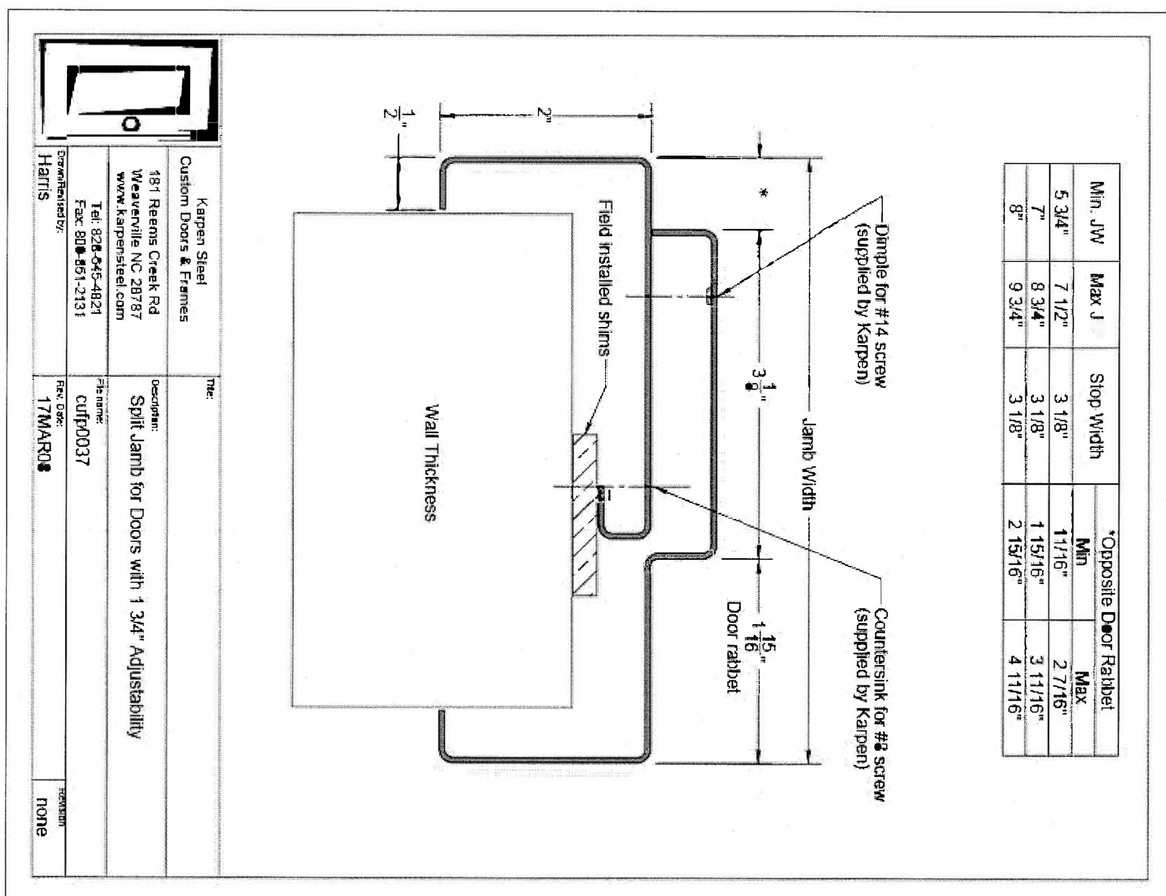

Project Title	CITY OF PHOENIX 27th AVE TRANSFER STATION
Drawing Title	DOOR PRODUCTS
Design Firm	GREEN MOUNTAIN TECHNOLOGIES 5350 McDonald Ave NE Bainbridge Island WA 98110
Consultant	-
Designed By	JPG & MBB
Date	2016.11.03
Drawn By	MTW
Revision	Revision
Checked By	MBB
Project ID	-
Reviewed By	MBB
Drawing Code	Drawing Code
Submitted By	GMT
CAD File Name	CoP ASP.vwx
Project Manager	-
Plot Date	00/00/00
Drawing No.	Con40Hi-03
Sheet	— of —
Total Sheets	
Scale	Sheet Scale


Review & Comment

Date: 2017, Jan 27
Time: 8:36:51 AM
File name: CoP TAP 40ft Container.vwx

No.	Date	Issue Notes

Green Mountain Technologies
Commercial Composting Solutions


PROPRIETARY INFORMATION: THIS DRAWING IS THE PROPERTY OF GREEN MOUNTAIN TECHNOLOGIES & SHALL NOT BE USED, COPIED OR REPRODUCED IN WHOLE OR IN PART, NOR SHALL THE CONTENTS BE REVEALED IN ANY MANNER TO ANYONE UNLESS WRITTEN PERMISSION IS OBTAINED FROM GREEN MOUNTAIN TECHNOLOGIES.

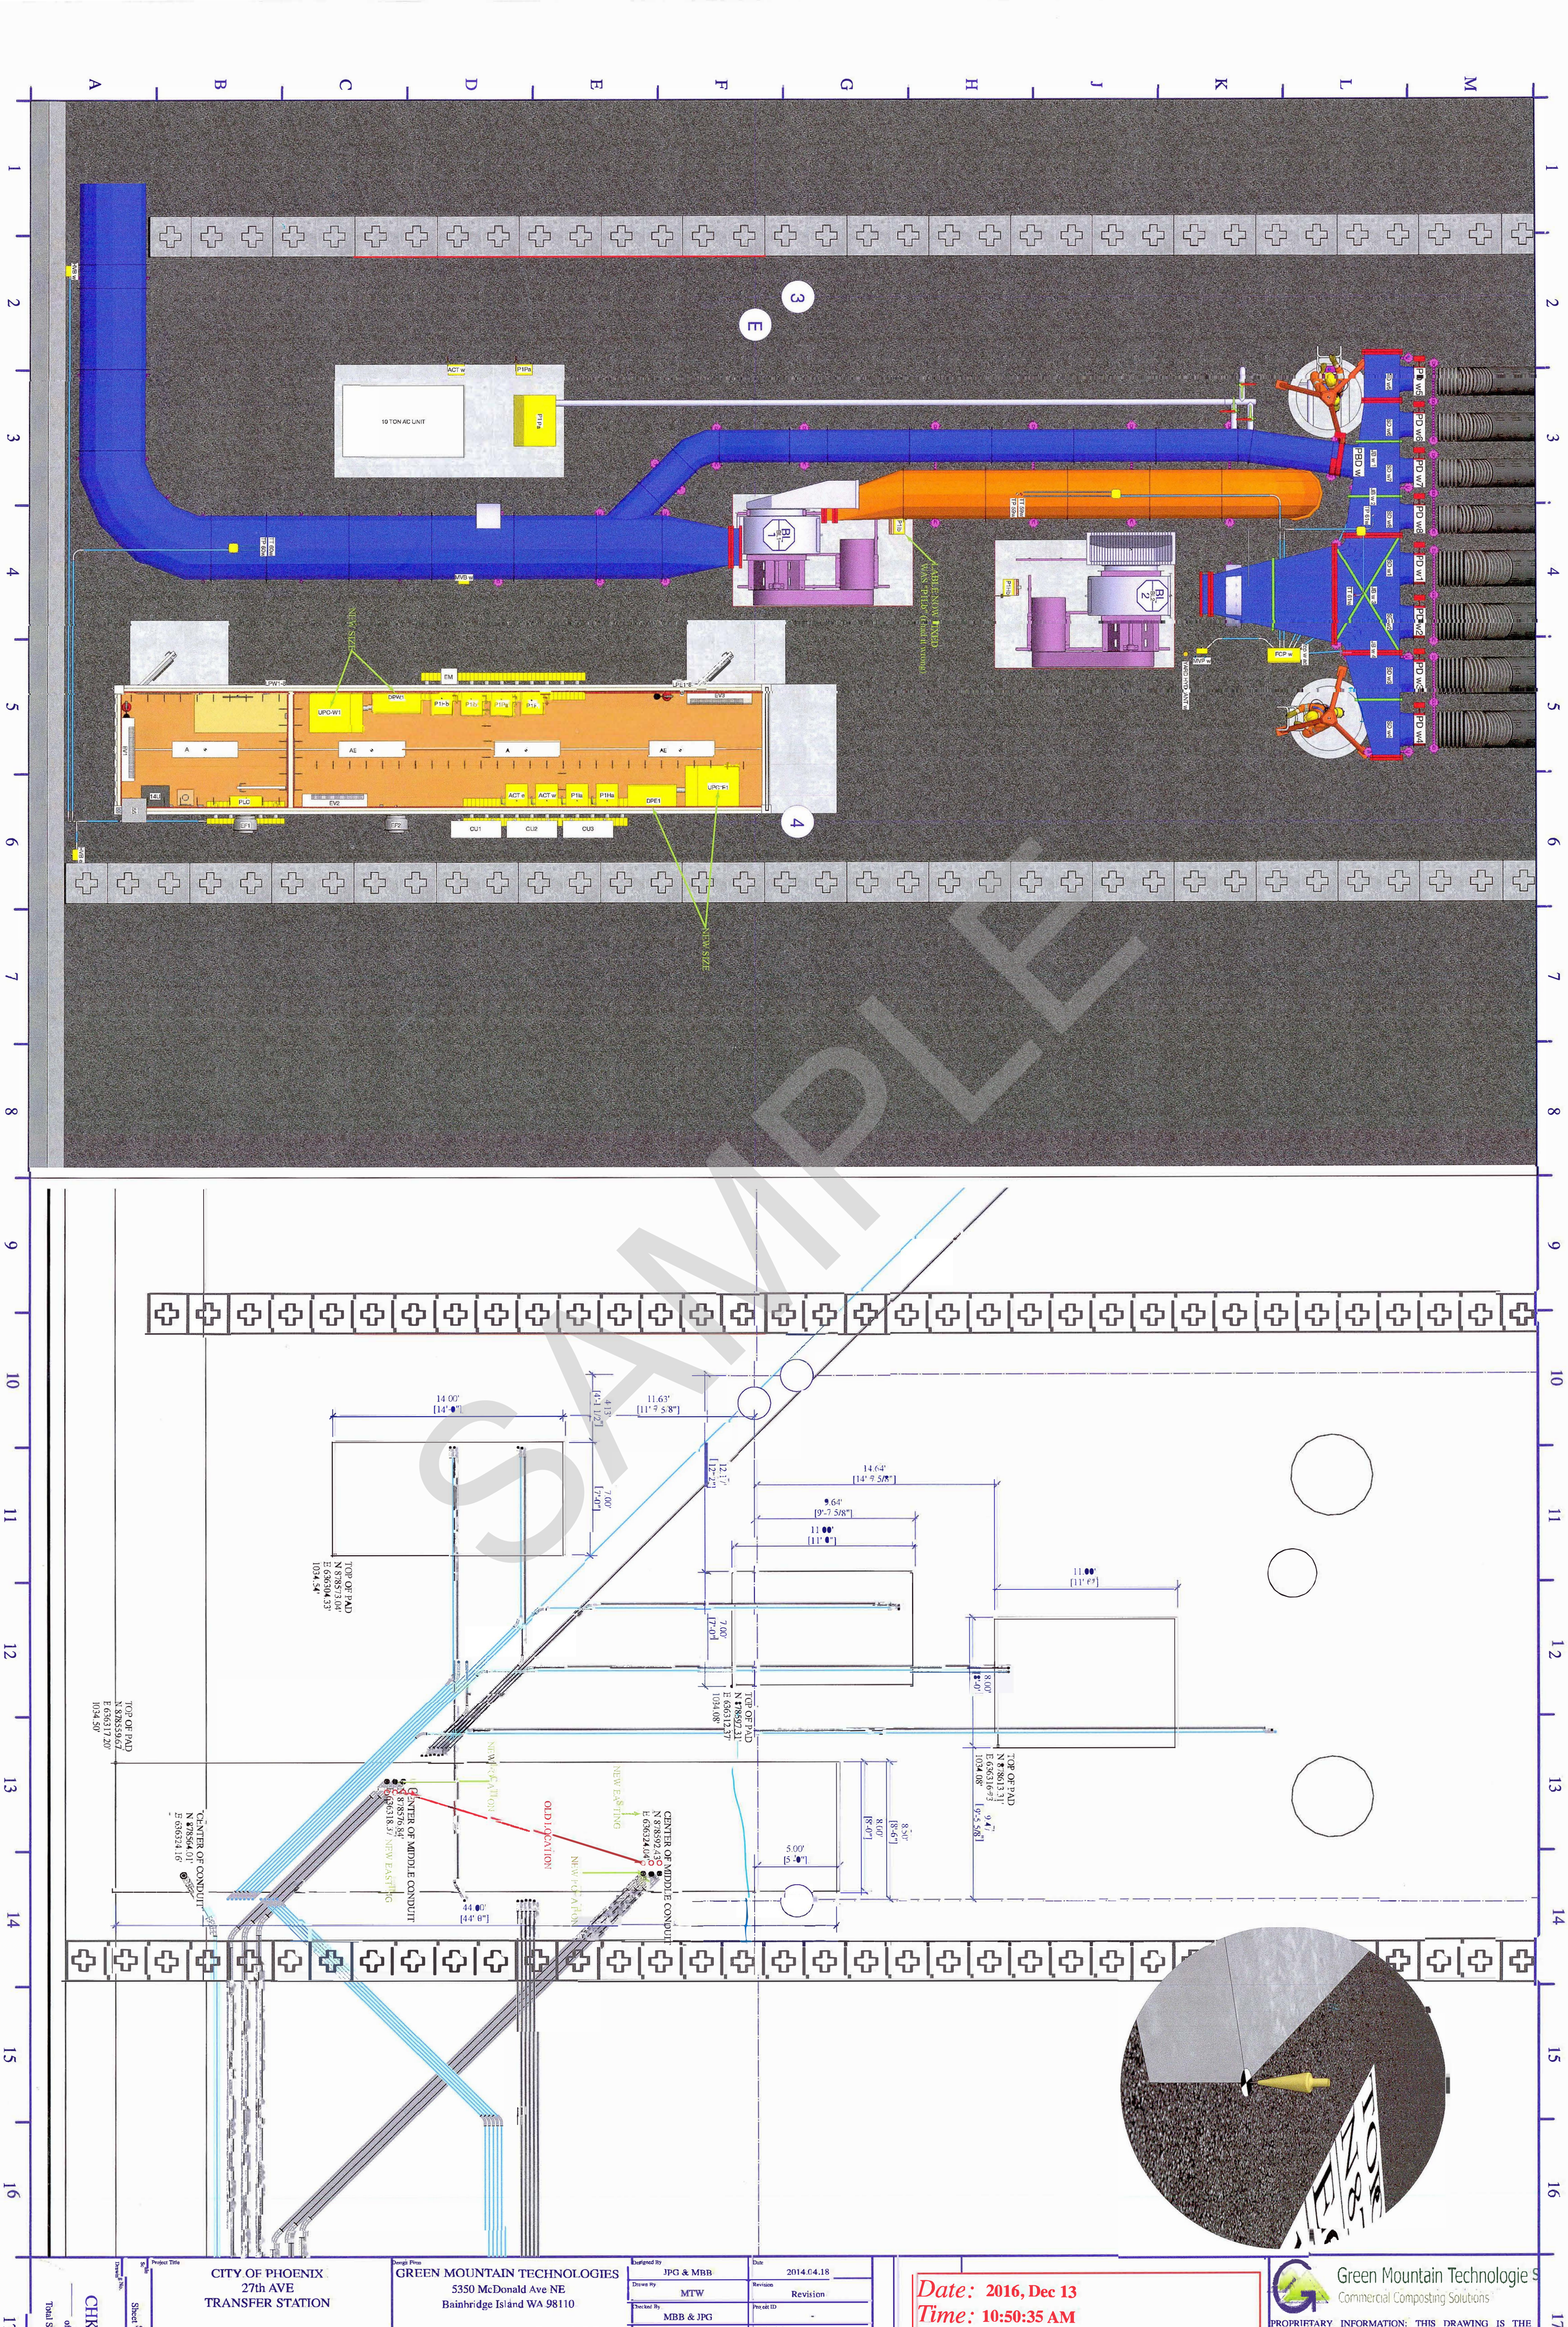

Project Title: CITY OF PHOENIX 27th AVE TRANSFER STATION	Design Firm: GREEN MOUNTAIN TECHNOLOGIES 5350 McDonald Ave NE Bainbridge Island WA 98110	Designed By: JPG & MBB	Date: 2014.04.18	*Date:* 2016, Dec 13	Green Mountain Technologie s Commercial Composting Solutions
Drawing Title: PLAN WEST BLOWER AREA XYZ OF PADS	Consultant: - - -	Drawn By: MTW	Revision: Revision	*Time:* 10:50:35 AM	
Sheet Scale		Checked By: MBB & JPG	Project ID: -	*File name:* CoP TAP Drawings CHK.vwx	
Drawing No. / Revision No.: CHK-47 — of — Total Sheets		Reviewed By: MBB & JPG	Drawing Code: Drawing Code		
		Submitted By: GMT	CAD File Name: CoP ASP.vwx		
		Project Manager: -	Plot Date: 00/00/00	No. / Date / Issue Notes	

PROPRIETARY INFORMATION: THIS DRAWING IS THE PROPERTY OF GREEN MOUNTAIN TECHNOLOGIES & SHALL NOT BE USED, COPIED OR REPRODUCED IN WHOLE OR IN PART, NOR SHALL THE CONTENTS BE REVEALED IN ANY MANNER TO ANYONE UNLESS WRITTEN PERMISSION IS OBTAINED FROM GREEN MOUNTAIN TECHNOLOGIES.

SAMPLE

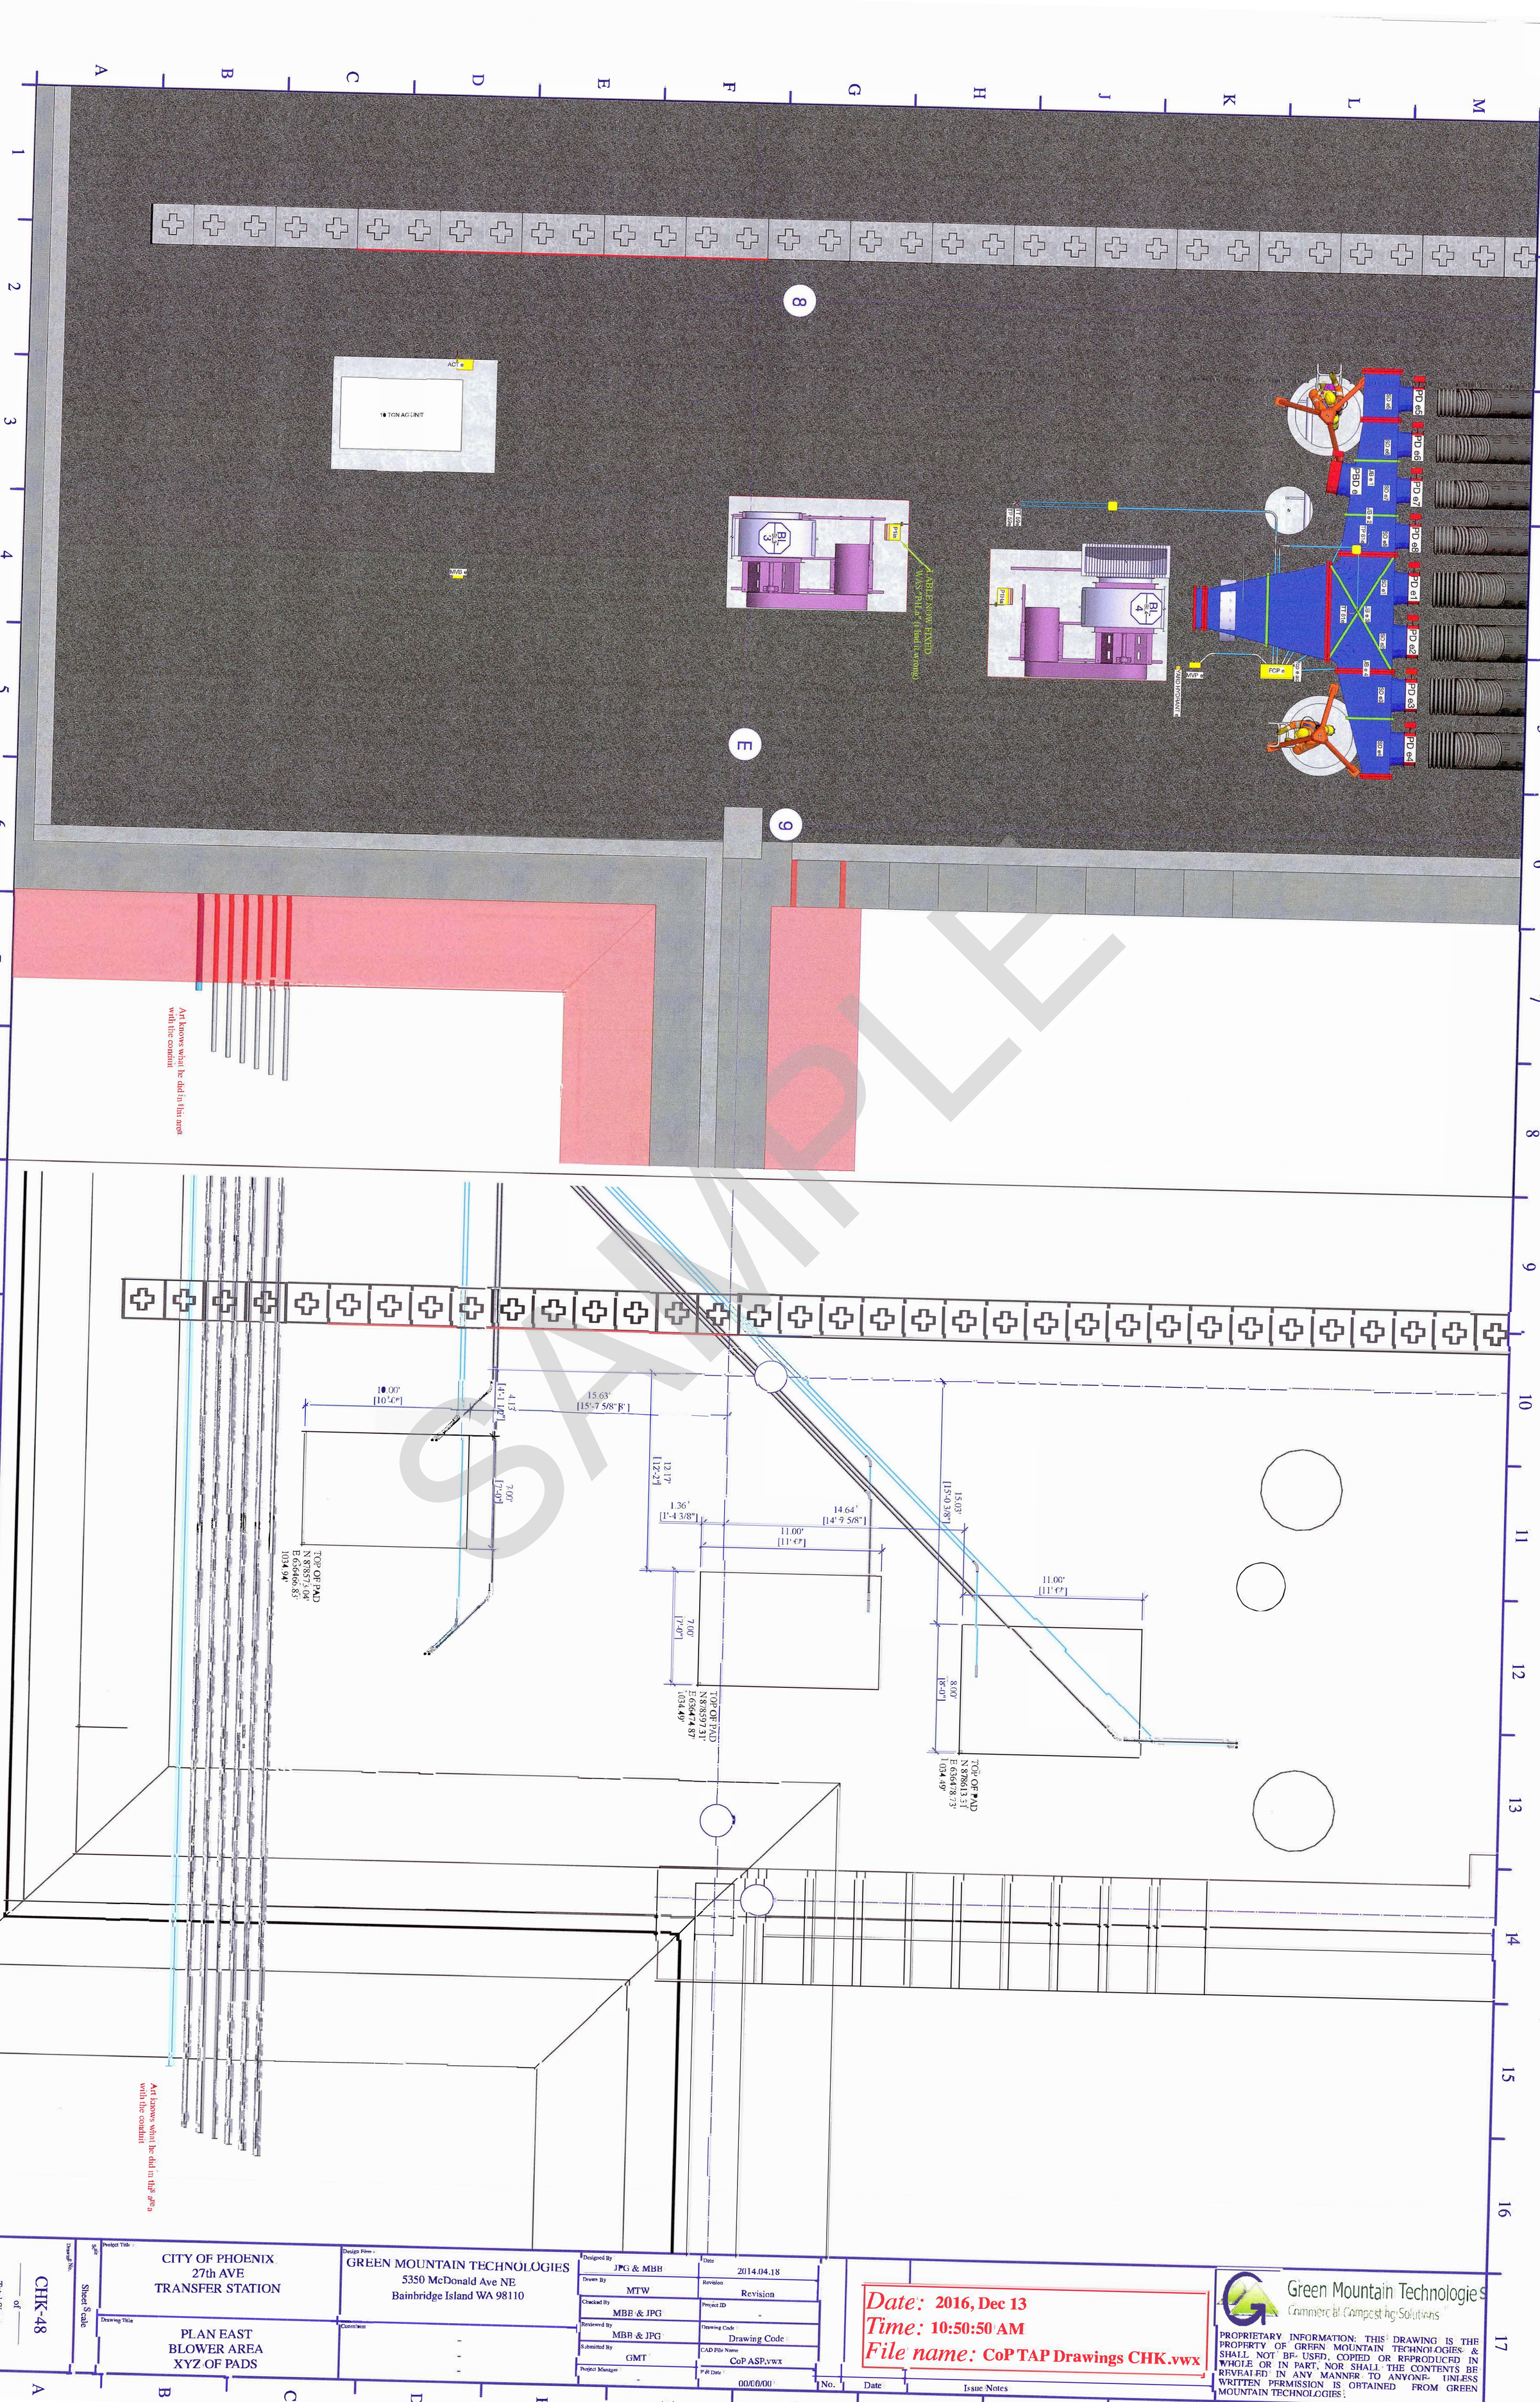

SAMPLE


Project Title: CITY OF PHOENIX 27th AVE TRANSFER STATION	Design Firm: GREEN MOUNTAIN TECHNOLOGIES 5350 McDonald Ave NE Bainbridge Island WA 98110	Designed By: JPG & MBB	Date: 2014.04.18	Drawing No.: CHK-48
		Drawn By: MTW	Revision: Revision	Sheet of Total Sheets: — of —
Drawing Title: PLAN EAST BLOWER AREA XYZ OF PADS	Consultant: - - -	Checked By: MBB & JPG	Project ID: -	Scale:
		Reviewed By: MBB & JPG	Drawing Code: Drawing Code	
		Submitted By: GMT	CAD File Name: CoP ASP.vwx	
		Project Manager: -	Plot Date: 00/00/00	

Date: **2016, Dec 13**
Time: **10:50:50 AM**
File name: **CoP TAP Drawings CHK.vwx**

No.	Date	Issue Notes

Green Mountain Technologies
Commercial Composting Solutions

PROPRIETARY INFORMATION: THIS DRAWING IS THE PROPERTY OF GREEN MOUNTAIN TECHNOLOGIES & SHALL NOT BE USED, COPIED OR REPRODUCED IN WHOLE OR IN PART, NOR SHALL THE CONTENTS BE REVEALED IN ANY MANNER TO ANYONE UNLESS WRITTEN PERMISSION IS OBTAINED FROM GREEN MOUNTAIN TECHNOLOGIES.

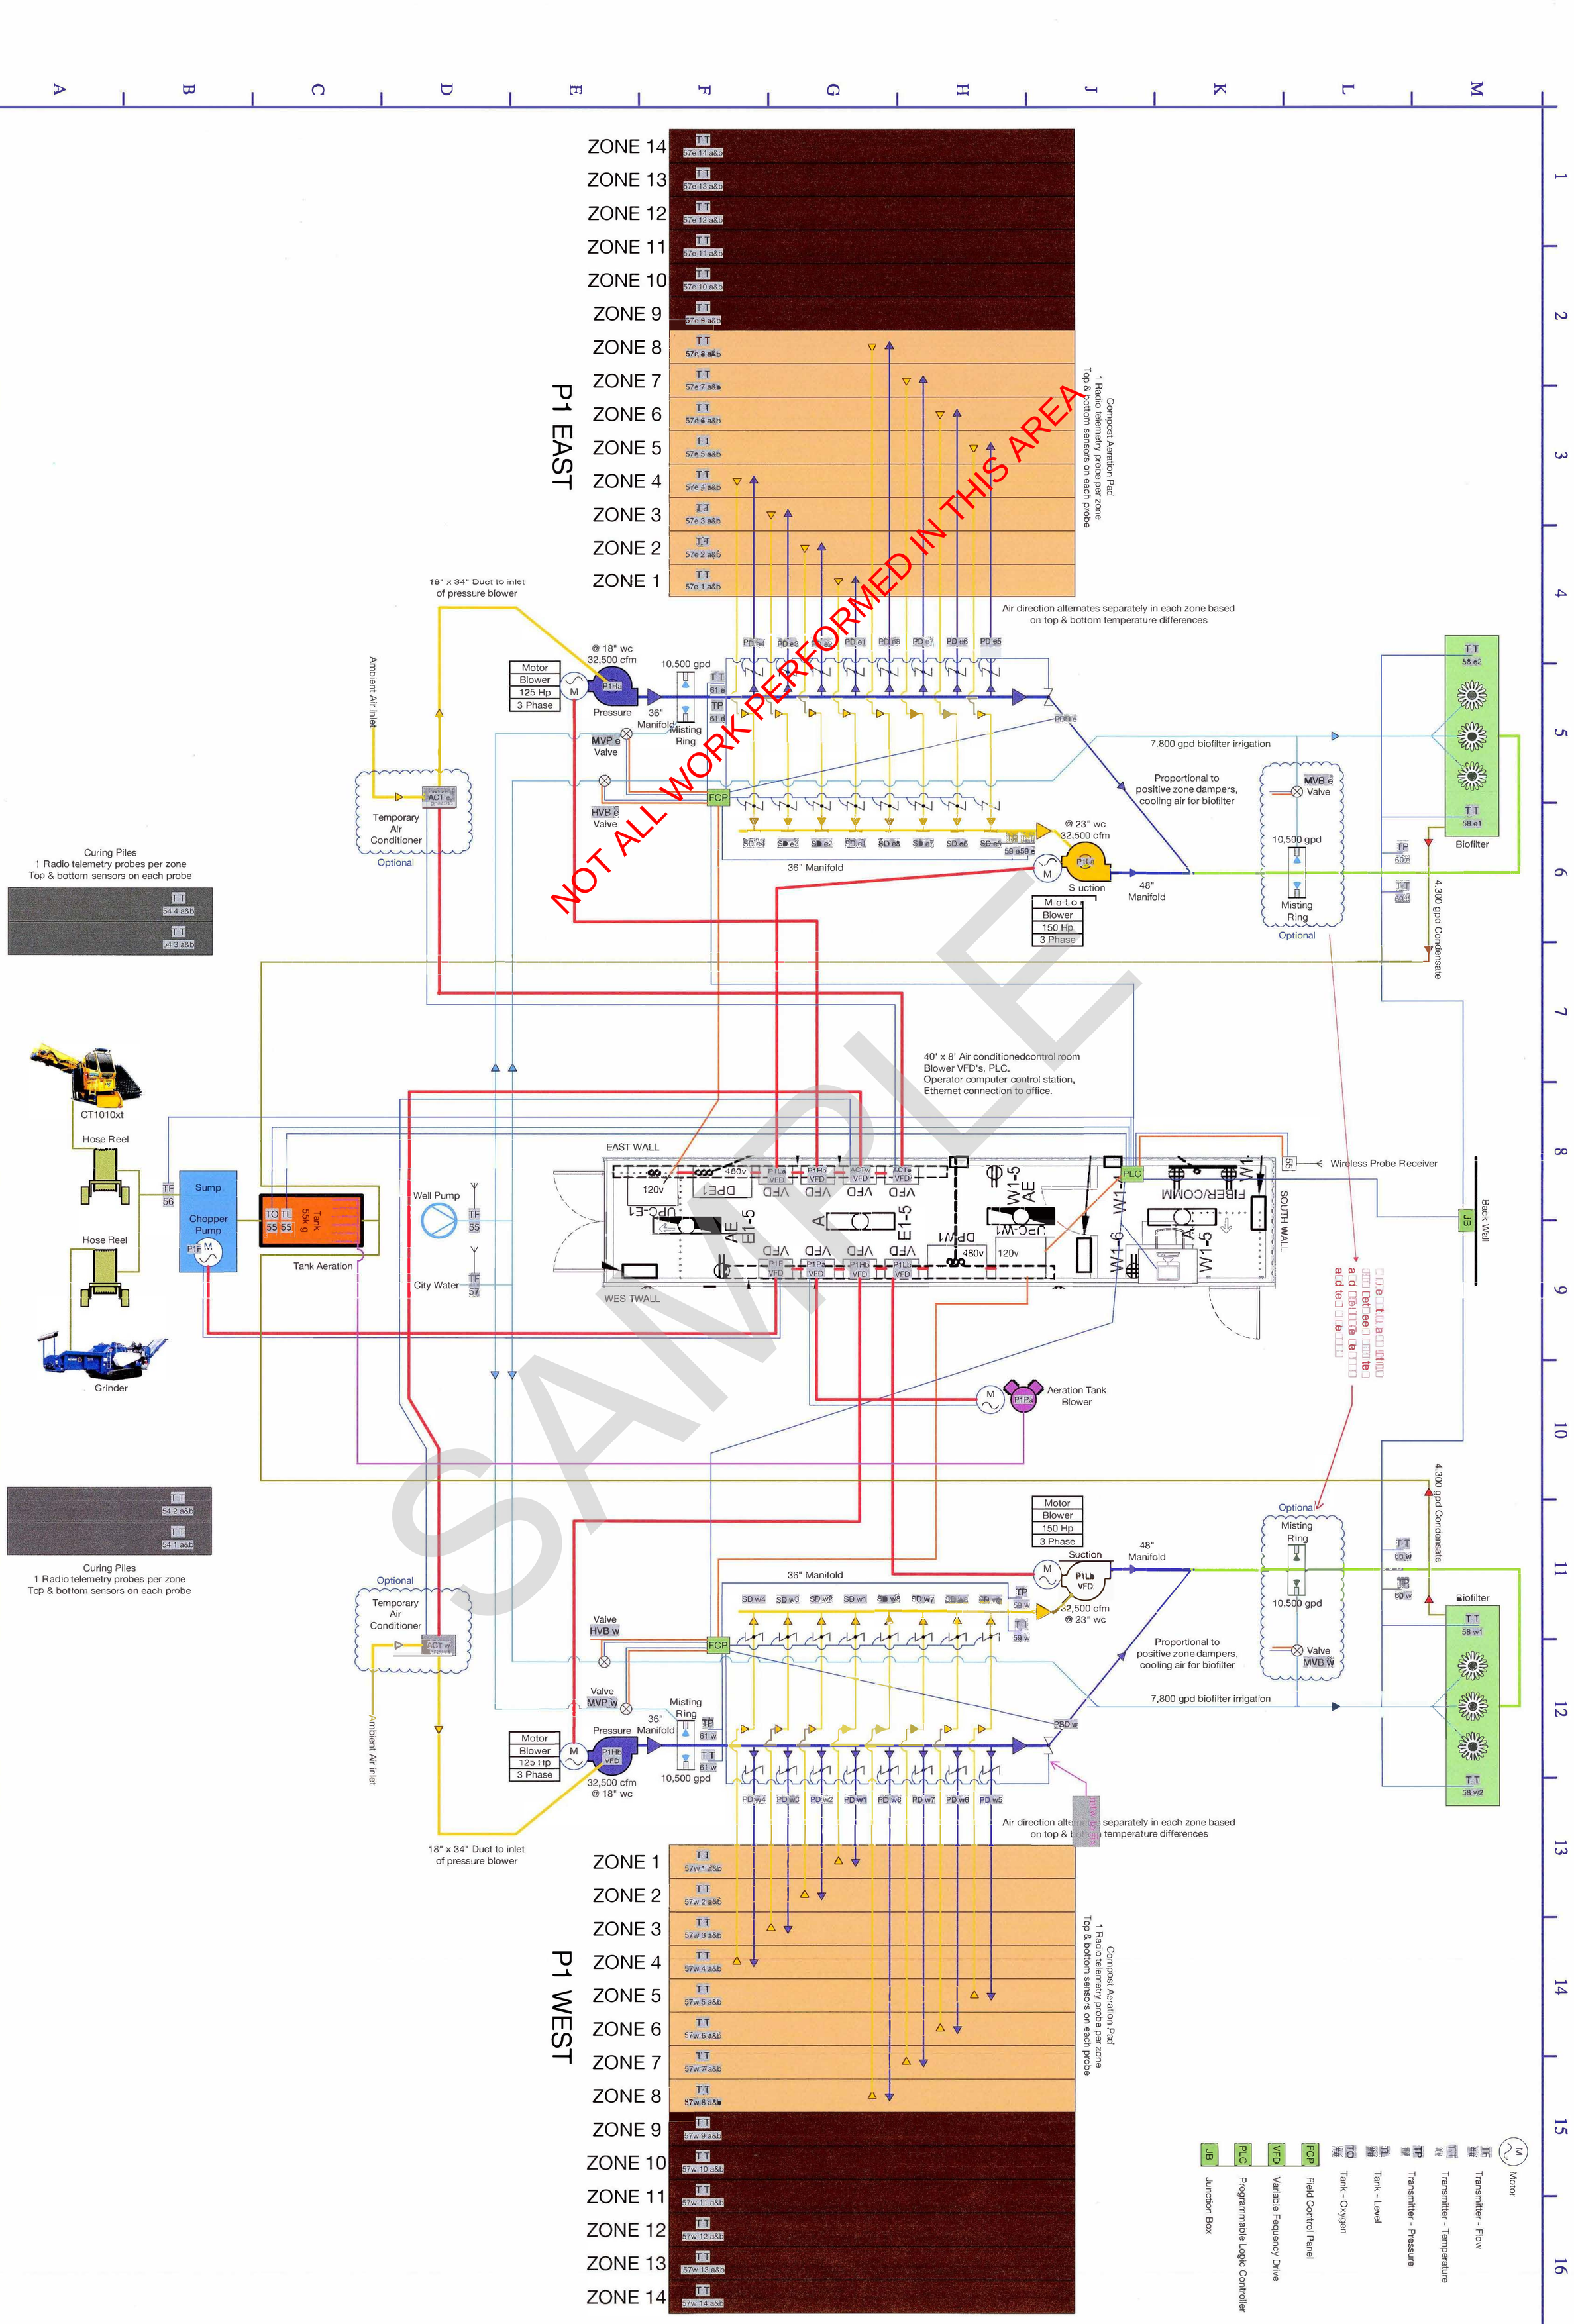

Project Title	CITY OF PHOENIX 27th AVE TRANSFER STATION
Design Firm	GREEN MOUNTAIN TECHNOLOGIES 5350 McDonald Ave NE Bainbridge Island WA 98110
Drawing Title	CoP P&ID Ver3
Consultant	-
Designed By	JPG
Drawn By	MTW
Checked By	MBB & JPG
Reviewed By	MBB & JPG
Submitted By	GMT
Project Manager	-
Date	--
Revision	Revision
Project ID	-
Drawing Code	Drawing Code
CAD File Name	ASP Compost Piles.vwx
Plot Date	00/00/00
Drawing No.	P&ID 01
Total Sheets	— of —
Scale	Sheet Scale

No.	Date	Issue Notes
5	2016.10.20	FOR CONTROLS VERIFICATION
4	2016.09.20 a	CONTAINER INTERIOR CLEAN UP
3	2016.09.20	REVISED W/ SINGLE PROBE/ZONE, TANK & CONTAINER
2	2015.12.18	REVIEW & COMMENTS
1	2015.09.09	FOR GMT REVIEW & COMMENT

Green Mountain Technologies
Commercial Composting Solutions

PROPRIETARY INFORMATION: THIS DRAWING IS THE PROPERTY OF GREEN MOUNTAIN TECHNOLOGIES & SHALL NOT BE USED, COPIED OR REPRODUCED IN WHOLE OR IN PART, NOR SHALL THE CONTENTS BE REVEALED IN ANY MANNER TO ANYONE UNLESS WRITTEN PERMISSION IS OBTAINED FROM GREEN MOUNTAIN TECHNOLOGIES.

SAMPLE

CoP I/O Lis All Phase 1 (P1) Version 3 Updated 10/20/2016 by jpg

2b

Point #	Dwg Symb.	Point Name	Device	Device Location	Opto 22 Point Type	Rack	Rack Location	Slot #	Opto 22 Module	Chan. #	Analog Scaling / Digital Normal output state	Notes
1	TT 57 w1a	West Zone 1 UpperTemp	EcoProbe Upper Temp	West pad zone 1	Wireless input point	1	40 ft Container	0	SNAP-SCM-485-422	N/A	N/A	EcoProbe wireless point obtained via Modbus RTU from ReoTemp wireless base. Communications through Opto 22 serial module in slot 0
2	TT 57 w1b	West Zone 1 LowerTemp	EcoProbe lowerTemp	West pad zone 1	Wireless input point	1	40 ft Container	0	SNAP-SCM-485-422	N/A	N/A	EcoProbe wireless point obtained via Modbus RTU from ReoTemp wireless base. Communications through Opto 22 serial module in slot 0
3	TT 57 w2a	West Zone 2 Upper Temp	EcoProbe Upper Temp	West pad zone 2	Wireless input point	1	40 ft Container	0	SNAP-SCM-485-422	N/A	N/A	EcoProbe wireless point obtained via Modbus RTU from ReoTemp wireless base. Communications through Opto 22 serial module in slot 0
4	TT 57 w2a	West Zone 2 Lower Temp	EcoProbe lower Temp	West pad zone 2	Wireless input point	1	40 ft Container	0	SNAP-SCM-485-422	N/A	N/A	EcoProbe wireless point obtained via Modbus RTU from ReoTemp wireless base. Communications through Opto 22 serial module in slot 0
5	TT 57 w3a	West Zone 3 UpperTemp	EcoProbe UpperTemp	West pad zone 3	Wireless input point	1	40 ft Container	0	SNAP-SCM-485-422	N/A	N/A	EcoProbe wireless point obtained via Modbus RTU from ReoTemp wireless base. Communications through Opto 22 serial module in slot 0
6	TT 57 w3b	West Zone 3 Lower Temp	EcoProbe lower Temp	West pad zone 3	Wireless input point	1	40 ft Container	0	SNAP-SCM-485-422	N/A	N/A	EcoProbe wireless point obtained via Modbus RTU from ReoTemp wireless base. Communications through Opto 22 serial module in slot 0
7	TT 57 w4a	West Zone 4 Upper Temp	EcoProbe UpperTemp	West pad zone 4	Wireless input point	1	40 ft Container	0	SNAP-SCM-485-422	N/A	N/A	EcoProbe wireless point obtained via Modbus RTU from ReoTemp wireless base. Communications through Opto 22 serial module in slot 0
8	TT 57 w4b	West Zone 4 LowerTemp	EcoProbe lower Temp	West pad zone 4	Wireless input point	1	40 ft Container	0	SNAP-SCM-485-422	N/A	N/A	EcoProbe wireless point obtained via Modbus RTU from ReoTemp wireless base. Communications through Opto 22 serial module in slot 0
9	TT 57 w 5a	West Zone 5 Upper Temp	EcoProbe UpperTemp	West pad zone 5	Wireless input point	1	40 ft Container	0	SNAP-SCM-485-422	N/A	N/A	EcoProbe wireless point obtained via Modbus RTU from ReoTemp wireless base. Communications through Opto 22 serial module in slot 0
10	TT 57 w 5b	West Zone 5 Lower Temp	EcoProbe lowerTemp	West pad zone 5	Wireless input point	1	40 ft Container	0	SNAP-SCM-485-422	N/A	N/A	EcoProbe wireless point obtained via Modbus RTU from ReoTemp wireless base. Communications through Opto 22 serial module in slot 0
11	TT 57 w6a	West Zone 6 UpperTemp	EcoProbe UpperTemp	West pad zone 6	Wireless input point	1	40 ft Container	0	SNAP-SCM-485-422	N/A	N/A	EcoProbe wireless point obtained via Modbus RTU from ReoTemp wireless base. Communications through Opto 22 serial module in slot 0
12	TT 57 w6b	West Zone 6 LowerTemp	EcoProbe lower Temp	West pad zone 6	Wireless input point	1	40 ft Container	0	SNAP-SCM-485-422	N/A	N/A	EcoProbe wireless point obtained via Modbus RTU from ReoTemp wireless base. Communications through Opto 22 serial module in slot 0
13	TT 57 w7a	West Zone 7 UpperTemp	EcoProbe UpperTemp	Westpad zone 7	Wireless input point	1	40 ft Container	0	SNAP-SCM-485-422	N/A	N/A	EcoProbe wireless point obtained via Modbus RTU from ReoTemp wireless base. Communications through Opto 22 serial module in slot 0
14	TT 57 w7b	West Zone 7 Lower Temp	EcoProbe lower Temp	West pad zone 7	Wireless input point	1	40 ft Container	0	SNAP-SCM-485-422	N/A	N/A	EcoProbe wireless point obtained via Modbus RTU from ReoTemp wireless base. Communications through Opto 22 serial module in slot 0
15	TT 57 w8a	West Zone 8 Upper Temp	EcoProbe UpperTemp	West pad zone 8	Wireless input point	1	40 ft Container	0	SNAP-SCM-485-422	N/A	N/A	EcoProbe wireless point obtained via Modbus RTU from ReoTemp wireless base. Communications through Opto 22 serial module in slot 0
16	TT 57 w8b	West Zone 8 LowerTemp	EcoProbe lower Temp	West pad zone 8	Wireless input point	1	40 ft Container	0	SNAP-SCM-485-422	N/A	N/A	EcoProbe wireless point obtained via Modbus RTU from ReoTemp wireless base. Communications through Opto 22 serial module in slot 0
17	TT 57 w9a	West Zone 9 Upper Temp	EcoProbe Upper Temp	Westpad zone 9	Wireless input point	1	40 ft Container	0	SNAP-SCM-485-422	N/A	N/A	EcoProbe wireless point obtained via Modbus RTU from ReoTemp wireless base. Communications through Opto 22 serial module in slot 0
18	TT 57 w9b	West Zone 9 Lower Temp	EcoProbe lowerTemp	West pad zone 9	Wireless input point	1	40 ft Container	0	SNAP-SCM-485-422	N/A	N/A	EcoProbe wireless point obtained via Modbus RTU from ReoTemp wireless base. Communications through Opto 22 serial module in slot 0
19	TT 57 w10a	West Zone 10 UpperTemp	EcoProbe Upper Temp	West pad zone 10	Wireless input point	1	40 ft Container	0	SNAP-SCM-485-422	N/A	N/A	EcoProbe wireless point obtained via Modbus RTU from ReoTemp wireless base. Communications through Opto 22 serial module in slot 0
20	TT57w10b	West Zone 10 Lower Temp	EcoProbe lower Temp	West pad zone 10	Wireless input point	1	40 ft Container	0	SNAP-SCM-485-422	N/A	N/A	EcoProbe wireless point obtained via Modbus RTU from ReoTemp wireless base. Communications through Opto 22 serial module in slot 0
21	TT 57 w11a	West Zone 11 Upper Temp	EcoProbe Upper Temp	West pad zone 11	Wireless input point	1	40 ft Container	0	SNAP-SCM-485-422	N/A	N/A	EcoProbe wireless point obtained via Modbus RTU from ReoTemp wireless base. Communications through Opto 22 serial module in slot 0
22	TT 57 w11b	West Zone 11 Lower Temp	EcoProbe lower Temp	West pad zone11	Wireless input point	1	40 ft Container	0	SNAP-SCM-485-422	N/A	N/A	EcoProbe wireless point obtained via Modbus RTU from ReoTemp wireless base. Communications through Opto 22 serial module in slot 0
23	TT 57 w12a	West Zone 12 UpperTemp	EcoProbe Upper Temp	West pad zone 12	Wireless input point	1	40 ft Container	0	SNAP-SCM-485-422	N/A	N/A	EcoProbe wireless point obtained via Modbus RTU from ReoTemp wireless base. Communications through Opto 22 serial module in slot 0
24	TT57w12b	West Zone 12 Lower Temp	EcoProbe lower Temp	West pad zone 12	Wireless input point	1	40 ft Container	0	SNAP-SCM-485-422	N/A	N/A	EcoProbe wireless point obtained via Modbus RTU from ReoTemp wireless base. Communications through Opto 22 serial module in slot 0
25	TT 57 w13a	West Zone 13 Upper Temp	EcoProbe Upper Temp	West pad zone 13	Wireless input point	1	40 ft Container	0	SNAP-SCM-485-422	N/A	N/A	EcoProbe wireless point obtained via Modbus RTU from ReoTemp wireless base. Communications through Opto 22 serial module in slot 0
26	TT 57 w13b	West Zone 13 Lower Temp	EcoProbe lower Temp	West pad zone 13	Wireless input point	1	40 ft Container	0	SNAP-SCM-485-422	N/A	N/A	EcoProbe wireless point obtained via Modbus RTU from ReoTemp wireless base. Communications through Opto 22 serial module in slot 0
27	TT 57 w14a	West Zone 14 Upper Temp	EcoProbe Upper Temp	West pad zone 14	Wireless input point	1	40 ft Container	0	SNAP-SCM-485-422	N/A	N/A	EcoProbe wireless point obtained via Modbus RTU from ReoTemp wireless base. Communications through Opto 22 serial module in slot 0
28	TT 57 w14b	West Zone 14 Lower Temp	EcoProbe lower Temp	West pad zone 14	Wireless input point	1	40 ft Container	0	SNAP-SCM-485-422	N/A	N/A	EcoProbe wireless point obtained via Modbus RTU from ReoTemp wireless base. Communications through Opto 22 serial module in slot 0
29	PD w1	West Zone 1 Positive damper	Belimo Damper actuator	West pad zone 1	4-20 mA output		FCP-West				4-20mA: 0deg-90deg	
30	SD w1	West Zone 1 Suction damper	Belimo Damper actuator	West pad zone 1	4-20 mA output		FCP-West				4-20mA: 0deg-90deg	
31	PD w2	West Zone 2 Positive damper	Belimo Damper actuator	West pad zone 2	4-20 mA output		FCP-West				4-20mA: 0deg-90deg	
32	SD w2	West Zone 2 Suction damper	Belimo Damper actuator	West pad zone 2	4-20 mA output		FCP-West				4-20mA: 0deg-90deg	
33	PD w3	West Zone 3 Positive damper	Belimo Damper actuator	West pad zone 3	4-20 mA output		FCP-West				4-20mA: 0deg-90deg	
34	SD w3	West Zone 3 Suction damper	Belimo Damper actuator	West pad zone 3	4-20 mA output		FCP-West				4-20mA: 0deg-90deg	
35	PD w4	West Zone 4 Positive damper	Belimo Damper actuator	West pad zone 4	4-20 mA output		FCP-West				4-20mA: 0deg90deg	
36	SD w4	West Zone 4 Suction damper	Belimo Damper actuator	West pad zone 4	4-20 mA output		FCP-West				4-20mA: 0deg-90deg	
37	PD w5	West Zone 5 Positive damper	Belimo Damper actuator	West pad zone 5	4-20 mA output		FCP-West				4-20mA: 0deg-90deg	
38	SD w5	West Zone 5 Suction damper	Belimo Damper actuator	West pad zone 5	4-20 mA output		FCP-West				4-20mA: 0deg-90deg	
39	PD w6	West Zone 6 Positive damper	Belimo Damper actuator	West pad zone 6	4-20 mA output		FCP-West				4-20mA: 0deg-90deg	
40	SD w6	West Zone 6 Suction damper	Belimo Damper actuator	West pad zone 6	4-20 mA output		FCP-West				4-20mA: 0deg-90deg	
41	PD w7	West Zone 7 Positive damper	Belimo Damper actuator	West pad zone 7	4-20 mA output		FCP-West				4-20mA: 0deg-90deg	
42	SD w7	West Zone 7 Suction damper	Belimo Damper actuator	West pad zone 7	4-20 mA output		FCP-West				4-20mA: 0deg-90deg	
43	PD w8	West Zone 8 Positive damper	Belimo Damper actuator	West pad zone 8	4-20 mA output		FCP-West				4-20mA: 0deg-90deg	
44	SD w8	West Zone 8 Suction damper	Belimo Damper actuator	West pad zone 8	4-20 mA output		FCP-West				4-20mA: 0deg-90deg	
45	PBD w	West Pressure Man. Bleed Air Damper	Belimo Damperactuator	West Pressure Manifold	4-20 mA output		FCP-West				4-20mA: 0deg-90deg	
46	P1Hb	West Pressure Blower VFD on/off	ABB VFD input	West Pressure Manifold	Contact Closure Output		FCP-West				N.O., Closed = On	
47	P1Hb	West Pressure Blower Speed	ABB VFD 4-20 mA speed control input	West Pressure Manifold	4-20 mA output		FCP-West				4-20mA = 0%-100%	
48	P1Hb	West Pressure Blower Fault	ABB VFD contact closure output	West Pressure Manifold	Contact Closure, Input		FCP-West				N.C., Open = fault	
49	TP 61 w	West Pressure Manifold pressure	Pressure sensor	West Pressure Manifold	4-20 mA Input		FCP-West				4-20mA = 0"-28"WC	
50	MVP w	West Pressure Manifold mister valve	Water solenoid valve 24VDC	West Pressure Manifold	Solid State Digital Output		FCP-West				N.O., Closed = On	
51	TT 61 w	West Pressure Manifold Temperature	100 ohm Pt RTD Xmitter	West Pressure Manifold	4-20 mA Input		FCP-West				4-20 mA = 0-100 deg C?	
52	TT 60 w	West Biofitler Manifold Temperature	100 ohm Pt RTD Xmitter	West Pressure Manifold	4-20mA Input		FCP-West				4-20 mA = 0-100 deg C?	
53	P1Lb	West Suction Blower VFD on/off	ABB VFD input	West Suction Manifold	Contact Closure Output		FCP-West				N.O., Closed = On	
54	P1Lb	West Suction Blower Speed	ABB VFD 4-20 mA speed control input	West Suction Manifold	4-20 mA output		FCP-West				4-20mA = 0%-100%	
55	P1Lb	West Suction Blower Fault	ABB VFD contact closure output	West Suction Manifold	Contact Closure, Input		FCP-West				N.C., Open = fault	
56	TP 59 w	West Suction Manifold Pressure	Pressure sensor	West Suction Manifold	4-20 mA Input		FCP-West				4-20mA = 0"-(-28)"WC	
57	TT 59 w	West Suction Manifold Temperature	100 ohm Pt RTD Xmitter	West Suction Manifold	4-20 mA Input		FCP-West				4-20 mA = 0-100 deg C?	
58	TP 60 w	West Biofilter Manifold Pressure	Pressure sensor	West Biofilter	4-20 mA Input		40 ft Container				4-20 mA = 0"-28"WC	
59	HVB w	West Biofilter hydration valve	Water solenoid valve AC	West Biofilter	Solid State Digital Output		40 ft Container				N.O., Closed = On	
60	MVB w	West Biofilter Duct mister valve	Water solenoid valve AC	West Biofilter	Solid State Digital Output		40 ft Container				N.O., Closed = On	
61	TT 58 w1	West Biofilter Pile Temperature 1	100 ohm Pt RTD Xmitter	West Biofilter	4-20 mA Input		40 ft Container				4-20 mA = 0-100 deg C?	
62	TT 58 w2	West Biofilter Pile Temperature 2	100 ohm Pt RTD Xmitter	West Biofilter	4-20 mA Input		40 ft Container				4-20 mA = 0-100 deg C?	
63	P1Pa	Aeration Tank Blower Motor	Motor Starter	Aeration tank	Solid State Digital Output		40 ft Container				N.O., Closed = On	
64	P1Pa	Aeration Tank Blower Motor Fault	Overload aux contact	Aeration tank	Contact Closure, Input		40 ft Container				N.C., Open = fault	
65	TL 55	Aeration Tank Level Sensor	Level Sensor	Aeration tank	4-20 mA Input		40 ft Container				4-20mA = 0%-100%	
66	TO 55	Aeration Tank O2 Sensor	Dissolved Oxgygen sensor	Aeration tank	4-20 mA Input		40 ft Container				4-20mA = 0%-100%	
67	TF 56	Aeration Tank water meter	Flow Meter	Aeration tank	4-20 mA Input		40 ft Container				??	
68	P1f	Chopper Pump	Contactor	Aeration tank	Solid State Digital Output		40 ft Container				N.O., Closed = On	
69	P1f	Chopper Pump Motor Fault	Overload aux contact	Aeration tank	Contact Closure, Input		40 ft Container				N.C., Open = fault	
70	TF 57	City Water meter	??	??							??	
71	TF 55	Well Water meter	??	??							??	
72	TT 57 e1a	East Zone 1 Upper Temp	EcoProbe Upper Temp	East pad zone 1	Wireless input point		40 ft Container		SNAP-SCM-485-422	N/A	N/A	EcoProbe wireless point obtained via Modbus RTU from ReoTemp wireless base. Communications through Opto 22 serial module in slot 0
73	TT 57 e1b	East Zone 1 Lower Temp	EcoProbe lower Temp	East pad zone 1	Wireless input point		40 ft Container		SNAP-SCM-485-422	N/A	N/A	EcoProbe wireless point obtained via Modbus RTU from ReoTemp wireless base. Communications through Opto 22 serial module in slot 0
74	TT 57 e2a	East Zone 2 Upper Temp	EcoProbe Upper Temp	East pad zone 2	Wireless input point		40 ft Container		SNAP-SCM-485-422	N/A	N/A	EcoProbe wireless point obtained via Modbus RTU from ReoTemp wireless base. Communications through Opto 22 serial module in slot 0
75	TT 57 e2b	East Zone 2 Lower Temp	EcoProbe lower Temp	East pad zone 2	Wireless input point		40 ft Container		SNAP-SCM-485-422	N/A	N/A	EcoProbe wireless point obtained via Modbus RTU from ReoTemp wireless base. Communications through Opto 22 serial module in slot 0
76	TT 57 e3a	East Zone 3 Upper Temp	EcoProbe Upper Temp	East pad zone 3	Wireless input point		40 ft Container		SNAP-SCM-485-422	N/A	N/A	EcoProbe wireless point obtained via Modbus RTU from ReoTemp wireless base. Communications through Opto 22 serial module in slot 0
77	TT 57 e3b	East Zone 3 Lower Temp	EcoProbe lower Temp	East pad zone 3	Wireless input point		40 ft Container		SNAP-SCM-485-422	N/A	N/A	EcoProbe wireless point obtained via Modbus RTU from ReoTemp wireless base. Communications through Opto 22 serial module in slot 0
78	TT 57 e4a	East Zone 4 Upper Temp	EcoProbe Upper Temp	East pad zone 4	Wireless input point		40 ft Container		SNAP-SCM-485-422	N/A	N/A	EcoProbe wireless point obtained via Modbus RTU from ReoTemp wireless base. Communications through Opto 22 serial module in slot 0
79	TT 57 e4b	East Zone 4 Lower Temp	EcoProbe lower Temp	East pad zone 4	Wireless input point		40 ft Container		SNAP-SCM-485-422	N/A	N/A	EcoProbe wireless point obtained via Modbus RTU from ReoTemp wireless base. Communications through Opto 22 serial module in slot 0
80	TT 57 e5a	East Zone 5 Upper Temp	EcoProbe Upper Temp	East pad zone 5	Wireless input point		40 ft Container		SNAP-SCM-485-422	N/A	N/A	EcoProbe wireless point obtained via Modbus RTU from ReoTemp wireless base. Communications through Opto 22 serial module in slot 0
81	TT 57 e5b	East Zone 5 Lower Temp	EcoProbe lowerTemp	East pad zone 5	Wireless input point		40 ft Container		SNAP-SCM-485-422	N/A	N/A	EcoProbe wireless point obtained via Modbus RTU from ReoTemp wireless base. Communications through Opto 22 serial module in slot 0
82	TT 57 e6a	East Zone 6 Upper Temp	EcoProbe Upper Temp	East pad zone 6	Wireless input point		40 ft Container		SNAP-SCM-485-422	N/A	N/A	EcoProbe wireless point obtained via Modbus RTU from ReoTemp wireless base. Communications through Opto 22 serial module in slot 0
83	TT 57 e6b	East Zone 6 Lower Temp	EcoProbe lower Temp	East pad zone 6	Wireless input point		40 ft Container		SNAP-SCM-485-422	N/A	N/A	EcoProbe wireless point obtained via Modbus RTU from ReoTemp wireless base. Communications through Opto 22 serial module in slot 0
84	TT 57 e7a	East Zone 7 Upper Temp	EcoProbe Upper Temp	East pad zone 7	Wireless input point		40 ft Container		SNAP-SCM-485-422	N/A	N/A	EcoProbe wireless point obtained via Modbus RTU from ReoTemp wireless base. Communications through Opto 22 serial module in slot 0
85	TT 57 e7b	East Zone 7 Lower Temp	EcoProbe lower Temp	East pad zone 7	Wireless input point		40 ft Container		SNAP-SCM-485-422	N/A	N/A	EcoProbe wireless point obtained via Modbus RTU from ReoTemp wireless base. Communications through Opto 22 serial module in slot 0
86	TT 57 e8a	East Zone 8 Upper Temp	EcoProbe Upper Temp	East pad zone 8	Wireless input point		40 ft Container		SNAP-SCM-485-422	N/A	N/A	EcoProbe wireless point obtained via Modbus RTU from ReoTemp wireless base. Communications through Opto 22 serial module in slot 0
87	TT 57 e8b	East Zone 8 Lower Temp	EcoProbe lower Temp	East pad zone 8	Wireless input point		40 ft Container		SNAP-SCM-485-422	N/A	N/A	EcoProbe wireless point obtained via Modbus RTU from ReoTemp wireless base. Communications through Opto 22 serial module in slot 0
88	TT 57 e9a	East Zone 9 Upper Temp	EcoProbe Upper Temp	East pad zone 9	Wireless input point		40 ft Container		SNAP-SCM-485-422	N/A	N/A	EcoProbe wireless point obtained via Modbus RTU from ReoTemp wireless base. Communications through Opto 22 serial module in slot 0
89	TT 57 e9b	East Zone 9 Lower Temp	EcoProbe lower Temp	East pad zone 9	Wireless Input point		40 ft Container		SNAP-SCM-485-422	N/A	N/A	EcoProbe wireless point obtained via Modbus RTU from ReoTemp wireless base. Communications through Opto 22 serial module in slot 0
90	TT 57 e10a	East Zone 10 Upper Temp	EcoProbe Upper Temp	East pad zone 10	Wireless input point		40 ft Container		SNAP-SCM-485-422	N/A	N/A	EcoProbe wireless point obtained via Modbus RTU from ReoTemp wireless base. Communications through Opto 22 serial module in slot 0
91	TT 57 e10b	East Zone 10 Lower Temp	EcoProbe lower Temp	East pad zone 10	Wireless input point		40 ft Container		SNAP-SCM-485-422	N/A	N/A	EcoProbe wireless point obtained via Modbus RTU from ReoTemp wireless base. Communications through Opto 22 serial module in slot 0
92	TT 57 e11a	East Zone 11 Upper Temp	EcoProbe Upper Temp	East pad zone 11	Wireless input point		40 ft Container		SNAP-SCM-485-422	N/A	N/A	EcoProbe wireless point obtained via Modbus RTU from ReoTemp wireless base. Communications through Opto 22 serial module in slot 0
93	TT 57 e11b	East Zone 11 Lower Temp	EcoProbe lower Temp	East pad zone 11	Wireless input point		40 ft Container		SNAP-SCM-485-422	N/A	N/A	EcoProbe wireless point obtained via Modbus RTU from ReoTemp wireless base. Communications through Opto 22 serial module in slot 0
94	TT 57 e12a	East Zone 12 Upper Temp	EcoProbe Upper Temp	East pad zone 12	Wireless input point		40 ft Container		SNAP-SCM-485-422	N/A	N/A	EcoProbe wireless point obtained via Modbus RTU from ReoTemp wireless base. Communications through Opto 22 serial module in slot 0
95	TT 57 e12b	East Zone 12 Lower Temp	EcoProbe lower Temp	East pad zone 12	Wireless input point		40 ft Container		SNAP-SCM-485-422	N/A	N/A	EcoProbe wireless point obtained via Modbus RTU from ReoTemp wireless base. Communications through Opto 22 serial module in slot 0
96	TT 57 e13a	East Zone 13 Upper Temp	EcoProbe Upper Temp	East pad zone 13	Wireless input point		40 ft Container		SNAP-SCM-485-422	N/A	N/A	EcoProbe wireless point obtained via Modbus RTU from ReoTemp wireless base. Communications through Opto 22 serial module in slot 0
97	TT 57 e13b	East Zone 13 Lower Temp	EcoProbe lower Temp	East pad zone 13	Wireless input point		40 ft Container		SNAP-SCM-485-422	N/A	N/A	EcoProbe wireless point obtained via Modbus RTU from ReoTemp wireless base. Communications through Opto 22 serial module in slot 0
98	TT 57 e14a	East Zone 14 Upper Temp	EcoProbe Upper Temp	East pad zone 14	Wireless input point		40 ft Container		SNAP-SCM-485-422	N/A	N/A	EcoProbe wireless point obtained via Modbus RTU from ReoTemp wireless base. Communications through Opto 22 serial module in slot 0
99	TT 57 e14b	East Zone 14 Lower Temp	EcoProbe lower Temp	East pad zone 14	Wireless input point		40 ft Container		SNAP-SCM-485-422	N/A	N/A	EcoProbe wireless point obtained via Modbus RTU from ReoTemp wireless base. Communications through Opto 22 serial module in slot 0
100	PDe1	East Zone 1 Positive damper	Belimo Damper actuator	East pad zone 1	4-20 mA output		FCP-East				4-20mA = 0deg-90deg	
101	SDe1	East Zone 1 Suction damper	Belimo Damper actuator	East pad zone 1	4-20 mA output		FCP-East				4-20mA = 0deg-90deg	
102	PDe2	East Zone 2 Positive damper	Belimo Damper actuator	East pad zone 2	4-20 mA output		FCP-East				4-20mA = 0deg-90deg	
103	SDe2	East Zone 2 Suction damper	Belimo Damper actuator	East pad zone 2	4-20 mA output		FCP-East				4-20mA = 0deg-90deg	
104	PDe3	East Zone 3 Positive damper	Belimo Damper actuator	East pad zone 3	4-20 mA output		FCP-East				4-20mA = 0deg-90deg	
105	SDe3	East Zone 3 Suction damper	Belimo Damper actuator	East pad zone 3	4-20 mA output		FCP-East				4-20mA = 0deg-90deg	
106	PDe4	East Zone 4 Positive damper	Belimo Damper actuator	East pad zone 4	4-20 mA output		FCP-East				4-20mA = 0deg-90deg	
107	SDe4	East Zone 4 Suction damper	Belimo Damper actuator	East pad zone 4	4-20 mA output		FCP-East				4-20mA = 0deg-90deg	
108	PD e5	East Zone 5 Positive damper	Belimo Damper actuator	East pad zone 5	4-20 mA output		FCP-East				4-20mA = 0deg-90deg	
109	SD e5	East Zone 5 Suction damper	Belimo Damperactuator	East pad zone 5	4-20 mA output		FCP-East				4-20mA = 0deg-90deg	
110	PDe6	East Zone 6 Positive damper	Belimo Damperactuator	East pad zone 6	4-20 mA output		FCP-East				4-20mA = 0deg-90deg	
111	SDe6	East Zone 6 Suction damper	Belimo Damper actuator	East pad zone 6	4-20 mA output		FCP-East				4-20mA = 0deg-90deg	
112	PDe7	East Zone 7 Positive damper	Belimo Damper actuator	East pad zone 7	4-20 mA output		FCP-East				4-20mA = 0deg-90deg	
113	SDe7	East Zone 7 Suction damper	Belimo Damper actuator	East pad zone 7	4-20 mA output		FCP-East				4-20mA = 0deg-90deg	
114	PDe8	East Zone 8 Positive damper	Belimo Damper actuator	East pad zone 8	4-20 mA output		FCP-East				4-20mA = 0deg-90deg	
115	SDe8	East Zone 8 Suction damper	Belimo Damper actuator	East pad zone 8	4-20 mA output		FCP-East				4-20mA = 0deg-90deg	
116	PDBe	East Pressure Man. Bleed Air Damper	Belimo Damper actuator	East Pressure Manifold	4-20 mA output		FCP-East				4-20mA: 0deg-90deg	
117	P1Ha	East Pressure Blower VFD on/off	ABB VFD input	East Pressure Manifold	Contact Closure Output		FCP-East				N.O., Closed = On	
118	P1Ha	East Pressure Blower Speed	ABB VFD 4-20 mA speed control input	East Pressure Manifold	4-20 mA output		FCP-East				4-20mA = 0%-100%	
119	P1Ha	East Pressure Blower Fault	ABB VFD contact closure output	East Pressure Manifold	Contact Closure, Input		FCP-East				N.C., Open = fault	
120	TP61 e	East Pressure Manifold pressure	Pressure sensor	East Pressure Manifold	4-20 mA Input		FCP-East				4-20mA = 0"-28"WC	
121	MVPe	East Pressure Manifold mister valve	Water solenoid valve 24VDC	East Pressure Manifold	Solid State Digital Output		FCP-East				N.O., Closed = On	
122	TT61 e	East Pressure ManifoldTemperature	100 ohm Pt RTD Xmitter	East Pressure Manifold	4-20 mA Input		FCP-East				4-20 mA = 0-100 deg C?	
123	TT 60 e	East Biofitler Manifold Temperature	100 ohm Pt RTD Xmitter	East Pressure Manifold	4-20 mA Input		FCP-East				4-20 mA = 0-100 deg C?	
124	P1La	East Suction Blower VFD on/off	ABB VFD input	East Suction Manifold	Contact Closure Output		FCP-East				N.O., Closed = On	
125	P1La	East Suction Blower Speed	ABB VFD 4-20 mA speed control input	East Suction Manifold	4-20 mA output		FCP-East				4-20mA = 0%-100%	
126	P1La	East Suction Blower Fault	ABB VFD contact closure output	East Suction Manifold	Contact Closure, Input		FCP-East				N.C., Open = fault	
127	TP 59 e	East Suction Manifold Pressure	Pressure sensor	East Suction Manifold	4-20 mA Input		FCP-East				4-20mA = 0"-(-28)"WC	
128	TT 59 e	East Suction Manifold Temperature	100 ohm Pt RTD Xmitter	East Suction Manifold	4-20 mA Input		FCP-East				4-20 mA = 0-100 deg C?	
129	TP 60 e	East Biofilter Manifold Pressure	Pressure sensor	East Biofilter	4-20 mA Input		40 ft Container				4-20 mA = 0"-28"WC	
130	HVB e	East Biofilter hydration valve	Water solenoid valve AC	East Biofilter	Solid State Digital Output		40 ft Container				N.O., Closed = On	
131	MVBe	East Biofilter Duct mister valve	Water solenoid valve AC	East Biofilter	Solid State Digital Output		40 ft Container				N.O., Closed = On	
132	TT58 e1	East Biofilter Pile Temperature 1	100 ohm Pt RTD Xmitter	East Biofilter	4-20 mA Input		40 ft Container				4-20 mA = 0-100 deg C?	
133	TT 58 e2	East Biofilter Pile Temperature 2	100 ohm Pt RTD Xmitter	East Biofilter	4-20 mA Input		40 ft Container				4-20 mA = 0-100 deg C?	
134	ACT w	West Temporary Air conditioner	?	West Biofilter	?		40 ft Container					
135	ACTe	East Temporary Air Conditioner	?	East Biofilter	?		40 ft Container					
136	TT 54 1a	Curing Pile Temperature	EcoProbe Upper Temp	Curing and product storage	wireless input point		40 ft Container		SNAP-SCM-485-422	N/A	N/A	EcoProbe wireless point obtained via Modbus RTU from ReoTemp wireless base. Communications through Opto 22 serial module in slot 0
137	TT 54 1b	Curing Pile Temperature	EcoProbe lower Temp	Curing and product storage	wireless input point		40 ft Container		SNAP-SCM-485-422	N/A	N/A	EcoProbe wireless point obtained via Modbus RTU from ReoTemp wireless base. Communications through Opto 22 serial module in slot 0
138	TT 54 2a	Curing Pile Temperature	EcoProbe Upper Temp	Curing and product storage	wireless input point		40 ft Container		SNAP-SCM-485-422	N/A	N/A	EcoProbe wireless point obtained via Modbus RTU from ReoTemp wireless base. Communications through Opto 22 serial module in slot 0
139	TT 54 2b	Curing Pile Temperature	EcoProbe lower Temp	Curing and product storage	wireless input point		40 ft Container		SNAP-SCM-485-422	N/A	N/A	EcoProbe wireless point obtained via Modbus RTU from ReoTemp wireless base. Communications through Opto 22 serial module in slot 0
140	TT 54 3a	Curing Pile Temperature	EcoProbe Upper Temp	Curing and product storage	wireless input point		40 ft Container		SNAP-SCM-485-422	N/A	N/A	EcoProbe wireless point obtained via Modbus RTU from ReoTemp wireless base. Communications through Opto 22 serial module in slot 0
141	TT 54 3b	Curing Pile Temperature	EcoProbe lower Temp	Curing and product storage	wireless input point		40 ft Container		SNAP-SCM-485-422	N/A	N/A	EcoProbe wireless point obtained via Modbus RTU from ReoTemp wireless base. Communications through Opto 22 serial module in slot 0
142	TT 54 4a	Curing Pile Temperature	EcoProbe Upper Temp	Curing and product storage	wireless input point		40 ft Container		SNAP-SCM-485-422	N/A	N/A	EcoProbe wireless point obtained via Modbus RTU from ReoTemp wireless base. Communications through Opto 22 serial module in slot 0
143	TT 54 4b	Curing Pile Temperature	EcoProbe lower Temp	Curing and product storage	wireless input point		40 ft Container		SNAP-SCM-485-422	N/A	N/A	EcoProbe wireless point obtained via Modbus RTU from ReoTemp wireless base. Communications through Opto 22 serial module in slot 0

SAMPLE

NOT ALL EQUIPMENT INSTALLED

Green Mountain Technologies
Commercial Composting Solutions

PROPRIETARY INFORMATION: THIS DRAWING IS THE PROPERTY OF GREEN MOUNTAIN TECHNOLOGIES & SHALL NOT BE USED, COPIED OR REPRODUCED IN WHOLE OR IN PART, NOR SHALL THE CONTENTS BE REVEALED IN ANY MANNER TO ANYONE UNLESS WRITTEN PERMISSION IS OBTAINED FROM GREEN MOUNTAIN TECHNOLOGIES.

No.	Date	Issue Notes
1	2016.10.20	FOR CONTROLS VERIFICATION

Designed By: JPG
Drawn By: MTW
Checked By: MBB & JPG
Reviewed By: MBB & JPG
Submitted By: GMT
Project Manager: -
Date: --
Revision: Revision
Project ID: -
Drawing Code: Drawing Code
CAD File Name: ASP Compost Piles.vwx
Plot Date: 00/00/00

Design Firm
GREEN MOUNTAIN TECHNOLOGIES
5350 McDonald Ave NE
Bainbridge Island WA 98110

Consultant
-
-
-

Project Title
CITY OF PHOENIX
27th AVE
TRANSFER STATION

Drawing Title
SPREAD SHEET


Scale
Sheet Scale

Drawing No.
P&ID 02
of
Total Sheets

M1

EXTERIOR ELEVATION LOOKING EAST


Scale: 3/4" = 1'-0"

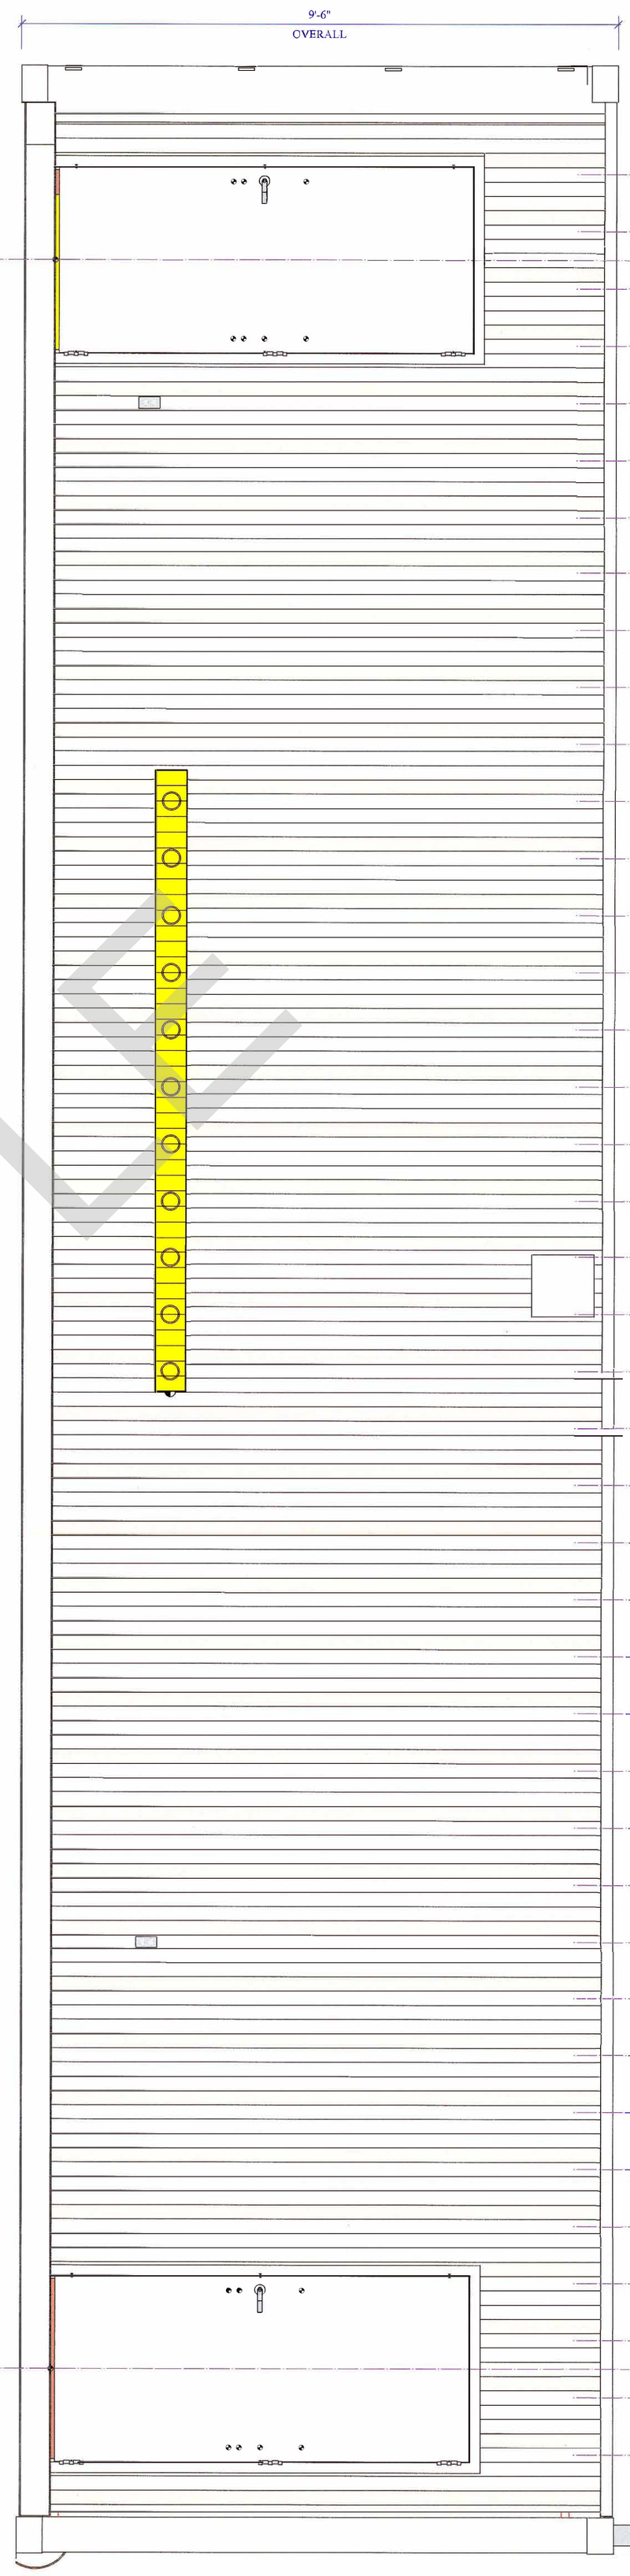

A1

PLAN

Scale: 3/4" = 1'-0"

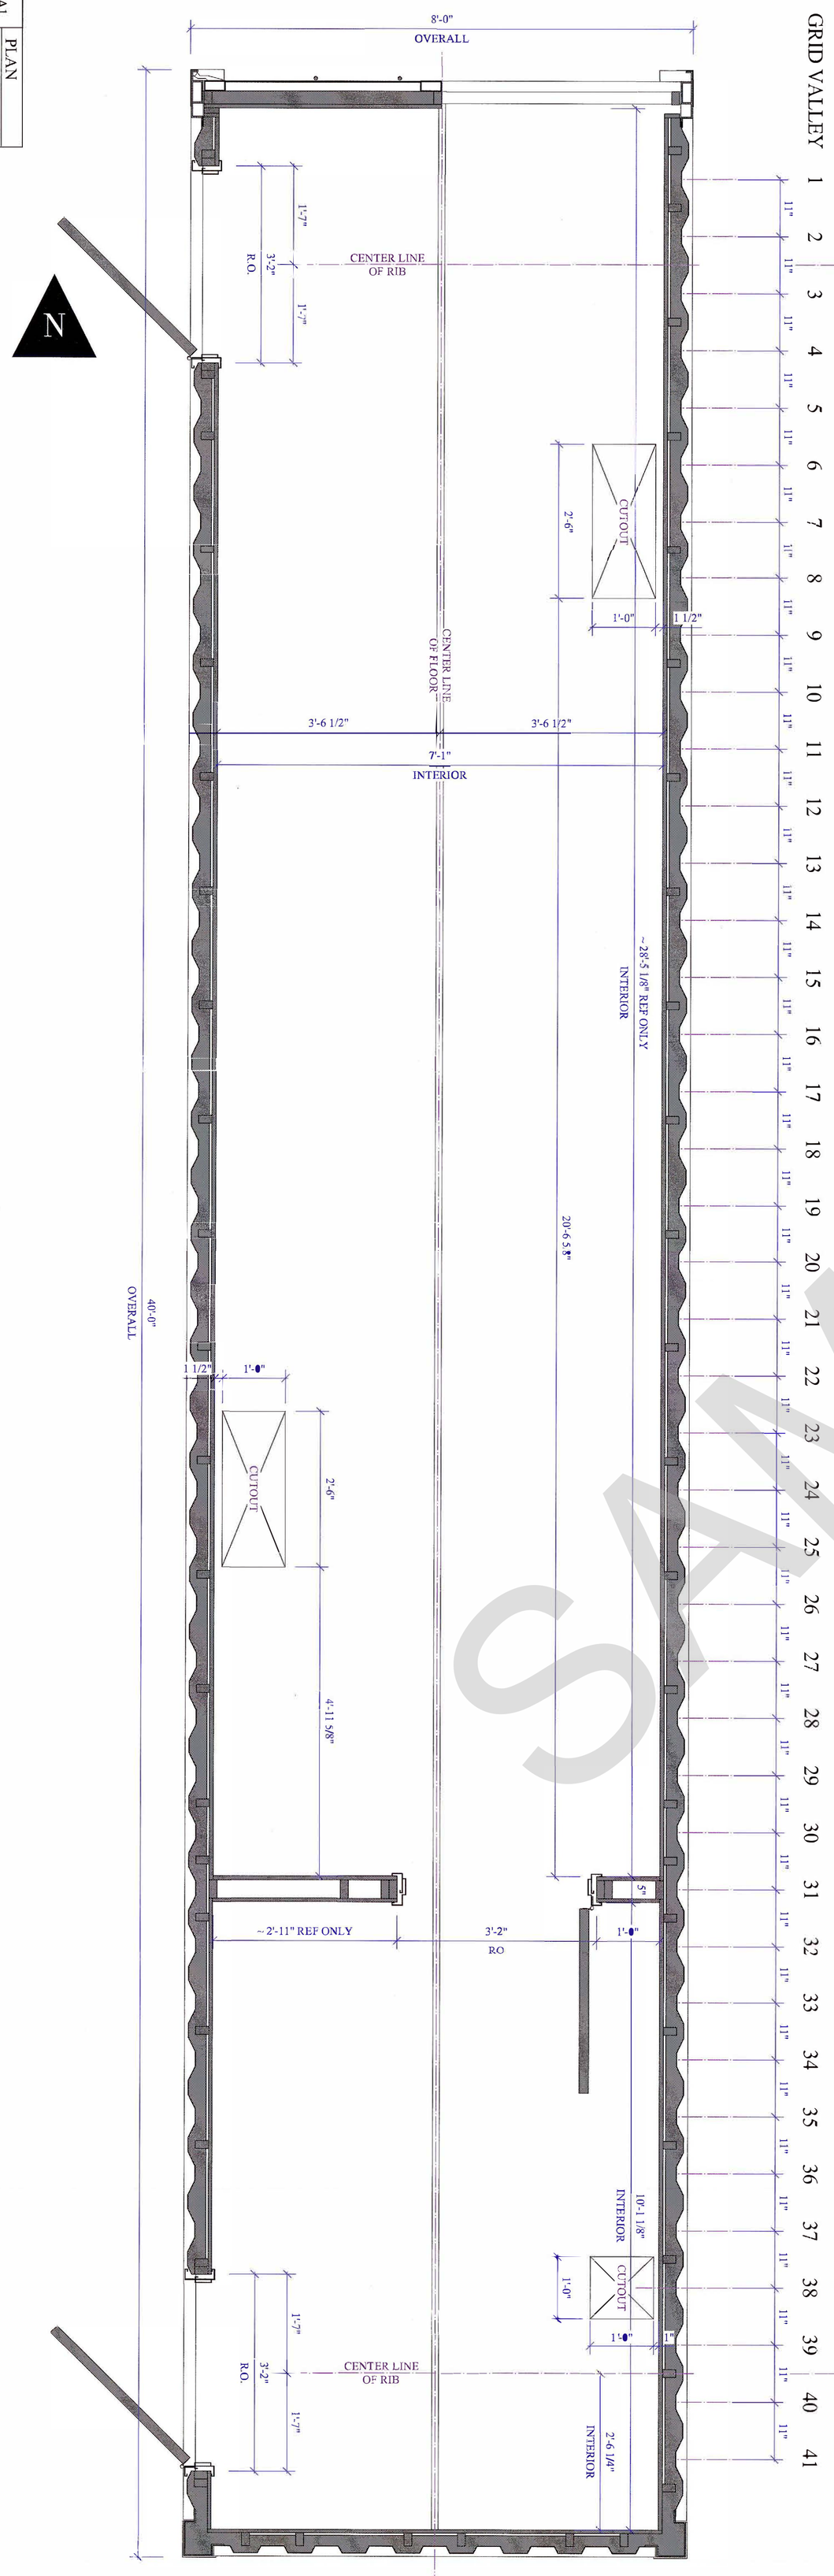

SAMPLE

Drawing No. Con40Hi-11 — of — Total Sheets	Scale Sheet Scale	Project Title: CITY OF PHOENIX 27th AVE TRANSFER STATION	Design Firm: GREEN MOUNTAIN TECHNOLOGIES 5350 McDonald Ave NE Bainbridge Island WA 98110	Designed By: JPG & MBB	Date: 2016.11.03
		Drawing Title: PLAN FRAMING & WEST ELEVATION	Consultant: - - -	Drawn By: MTW	Revision: Revision
				Checked By: MBB	Project ID: -
				Reviewed By: MBB	Drawing Code: Drawing Code
				Submitted By: GMT	CAD File Name: CoP ASP.vwx
				Project Manager: -	Plot Date: 00/00/00

PROGRESS PRINT

Date: 2016, Dec 13

Time: 3:17:23 PM


File name: CoP TAP 40ft Container.vwx

No.

Green Mountain Technologies
Commercial Composting Solutions


PROPRIETARY INFORMATION: THIS DRAWING IS THE PROPERTY OF GREEN MOUNTAIN TECHNOLOGIES & SHALL NOT BE USED, COPIED OR REPRODUCED IN WHOLE OR IN PART, NOR SHALL THE CONTENTS BE REVEALED IN ANY MANNER TO ANYONE UNLESS WRITTEN PERMISSION IS OBTAINED FROM GREEN MOUNTAIN TECHNOLOGIES.

A1 | PLAN
Scale: 3/4" = 1'-0"

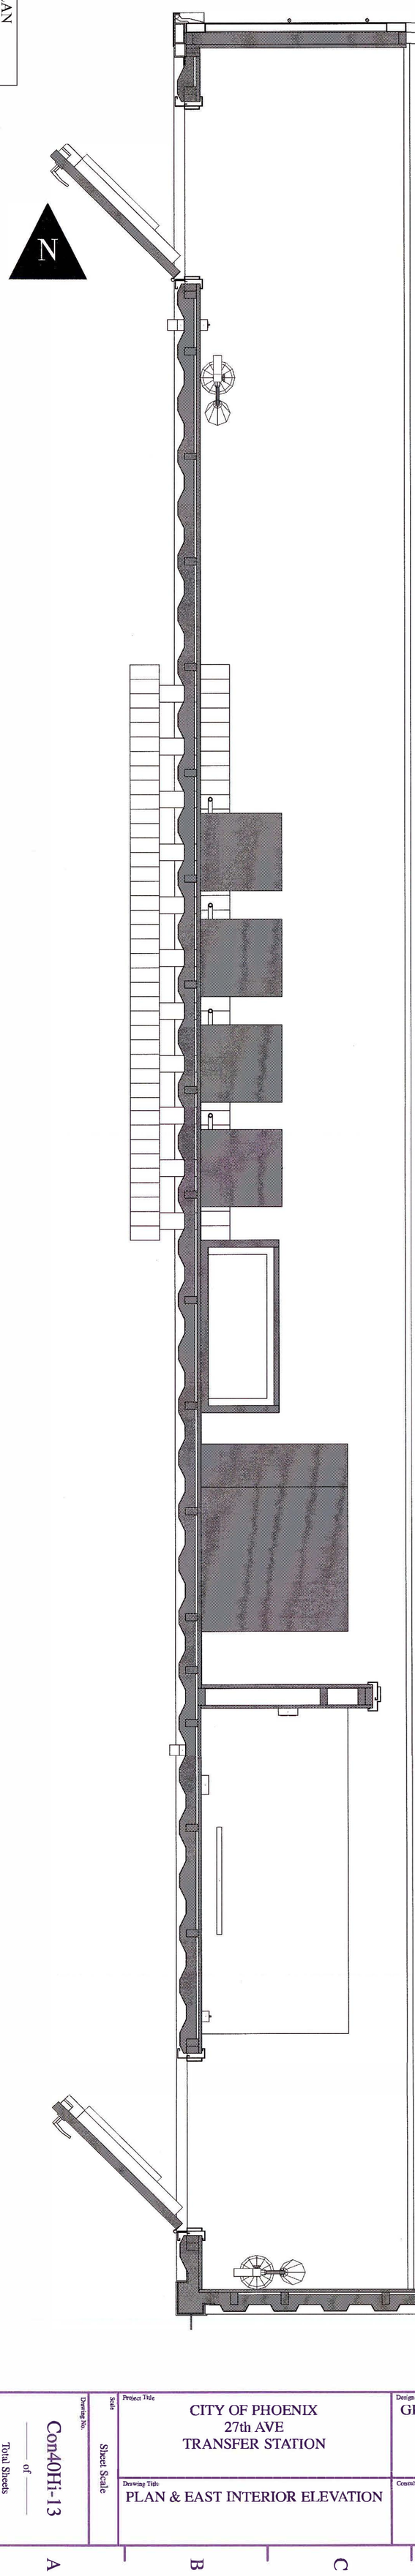

GRID VALLEY

M1 | INTERIOR ELEVATION LOOKING EAST
Scale: 3/4" = 1'-0"

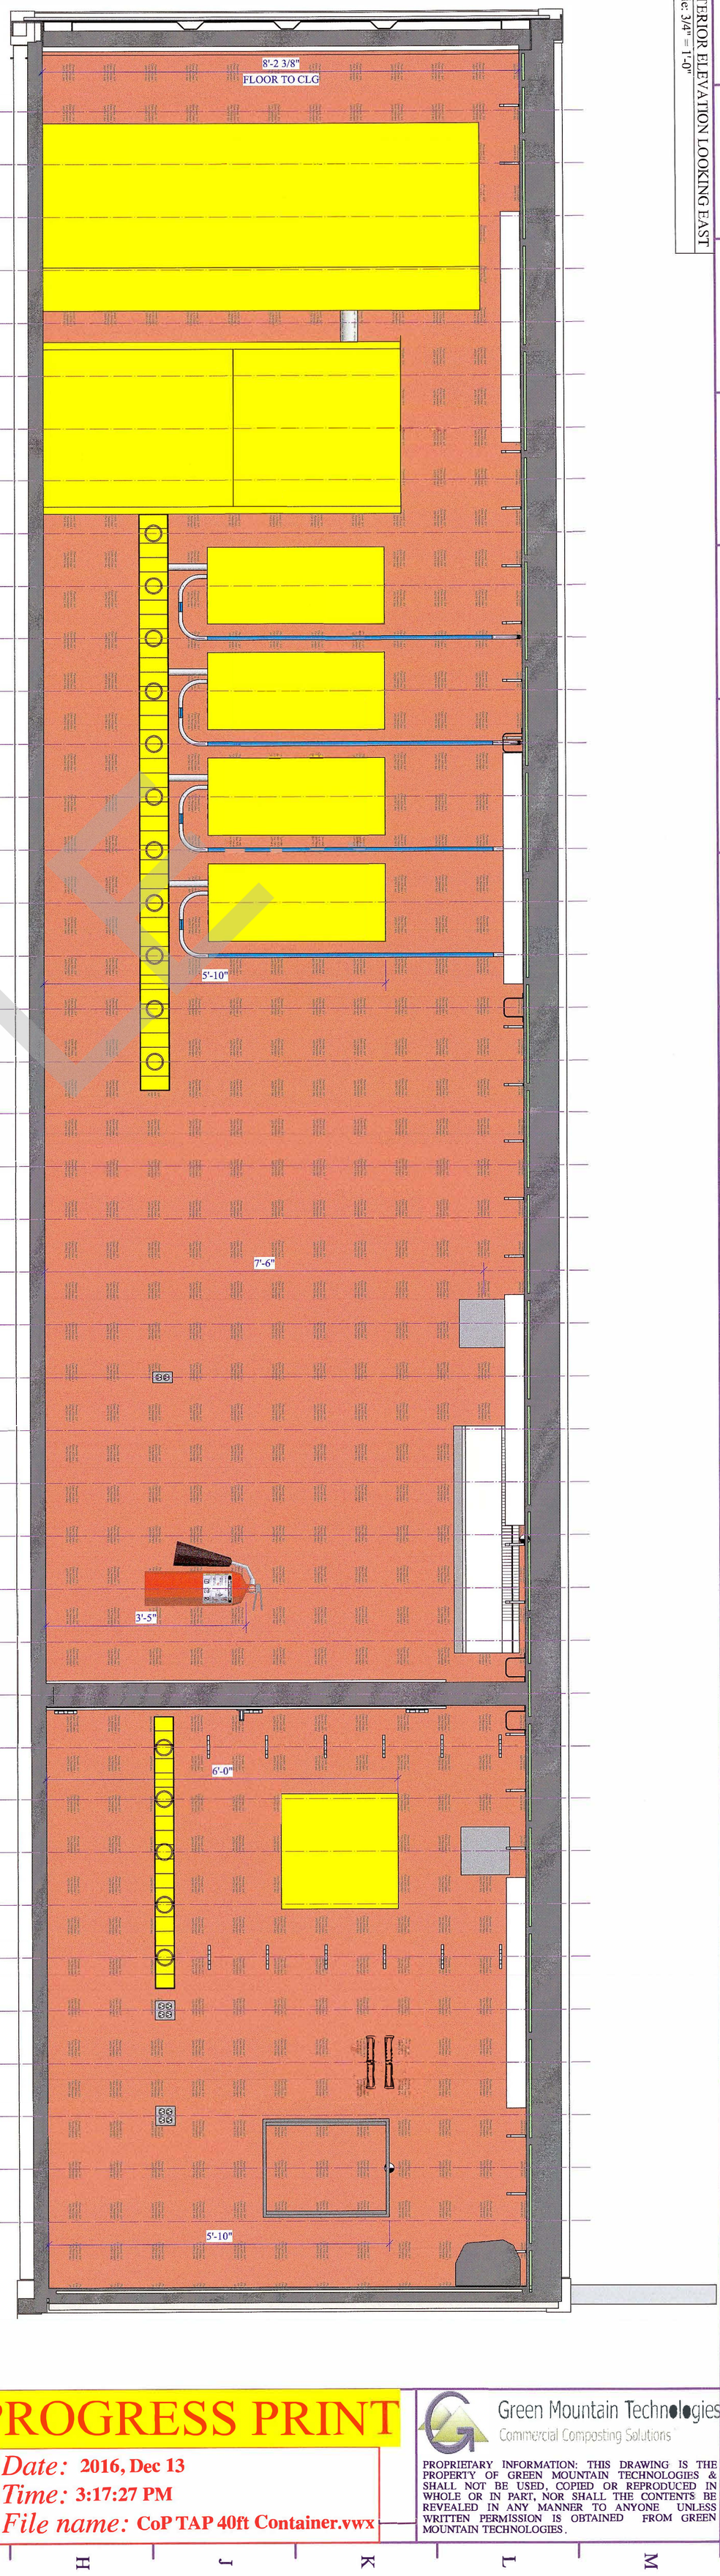

SAMPLE

Drawing No. Con40Hi-13 — of — Total Sheets	Scale Sheet Scale	Project Title: CITY OF PHOENIX 27th AVE TRANSFER STATION	Design Firm: GREEN MOUNTAIN TECHNOLOGIES 5350 McDonald Ave NE Bainbridge Island WA 98110	Designed By: JPG & MBB	Date: 2016.11.03
		Drawing Title: PLAN & EAST INTERIOR ELEVATION	Consultant: - - -	Drawn By: MTW	Revision: Revision
				Checked By: MBB	Project ID: -
				Reviewed By: MBB	Drawing Code: Drawing Code
				Submitted By: GMT	CAD File Name: CoP ASP.vwx
				Project Manager: -	Plot Date: 00/00/00

PROGRESS PRINT

Date: 2016, Dec 13
Time: 3:17:27 PM
File name: CoP TAP 40ft Container.vwx


No.


Green Mountain Technologies
Commercial Composting Solutions

PROPRIETARY INFORMATION: THIS DRAWING IS THE PROPERTY OF GREEN MOUNTAIN TECHNOLOGIES & SHALL NOT BE USED, COPIED OR REPRODUCED IN WHOLE OR IN PART, NOR SHALL THE CONTENTS BE REVEALED IN ANY MANNER TO ANYONE UNLESS WRITTEN PERMISSION IS OBTAINED FROM GREEN MOUNTAIN TECHNOLOGIES.

A1 | PLAN
Scale: 3/4" = 1'-0"

M1 | INTERIOR ELEVATION LOOKING WEST
Scale: 3/4" = 1'-0"

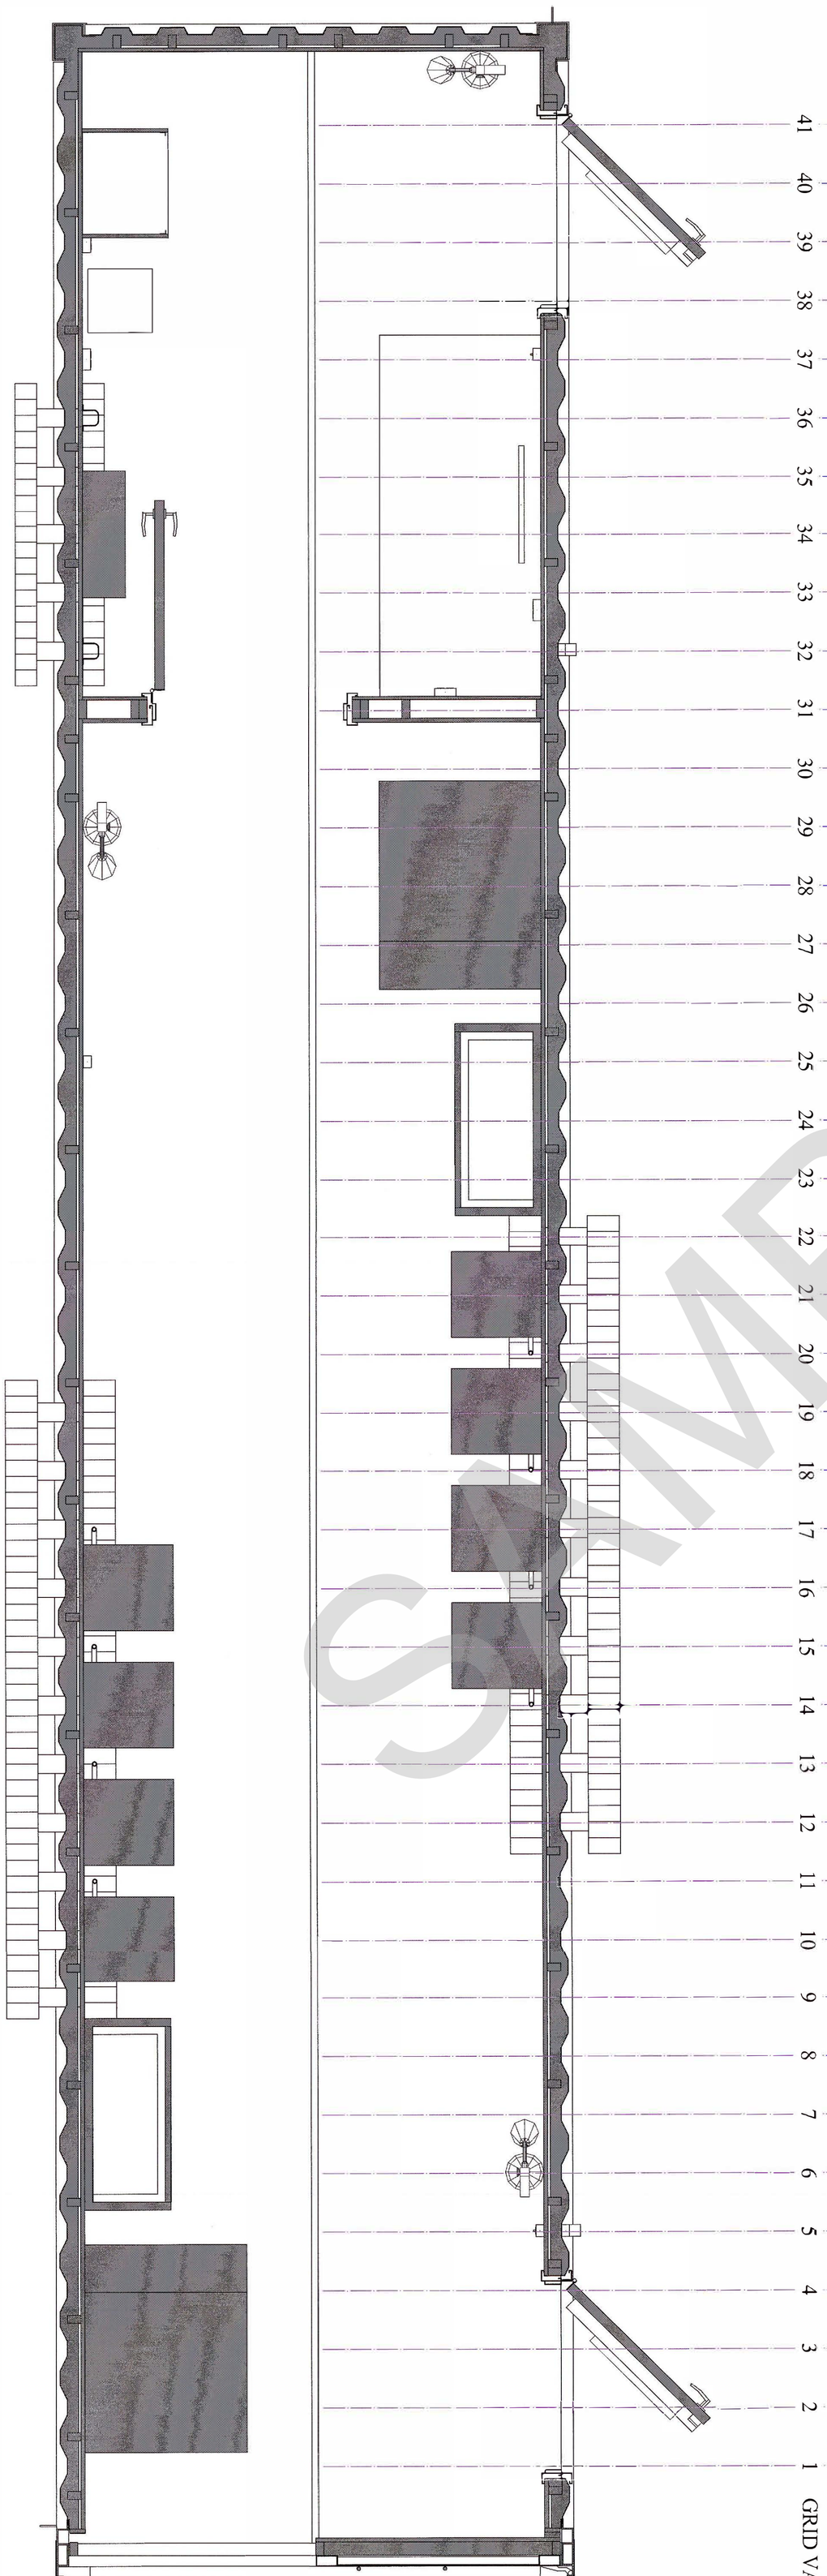

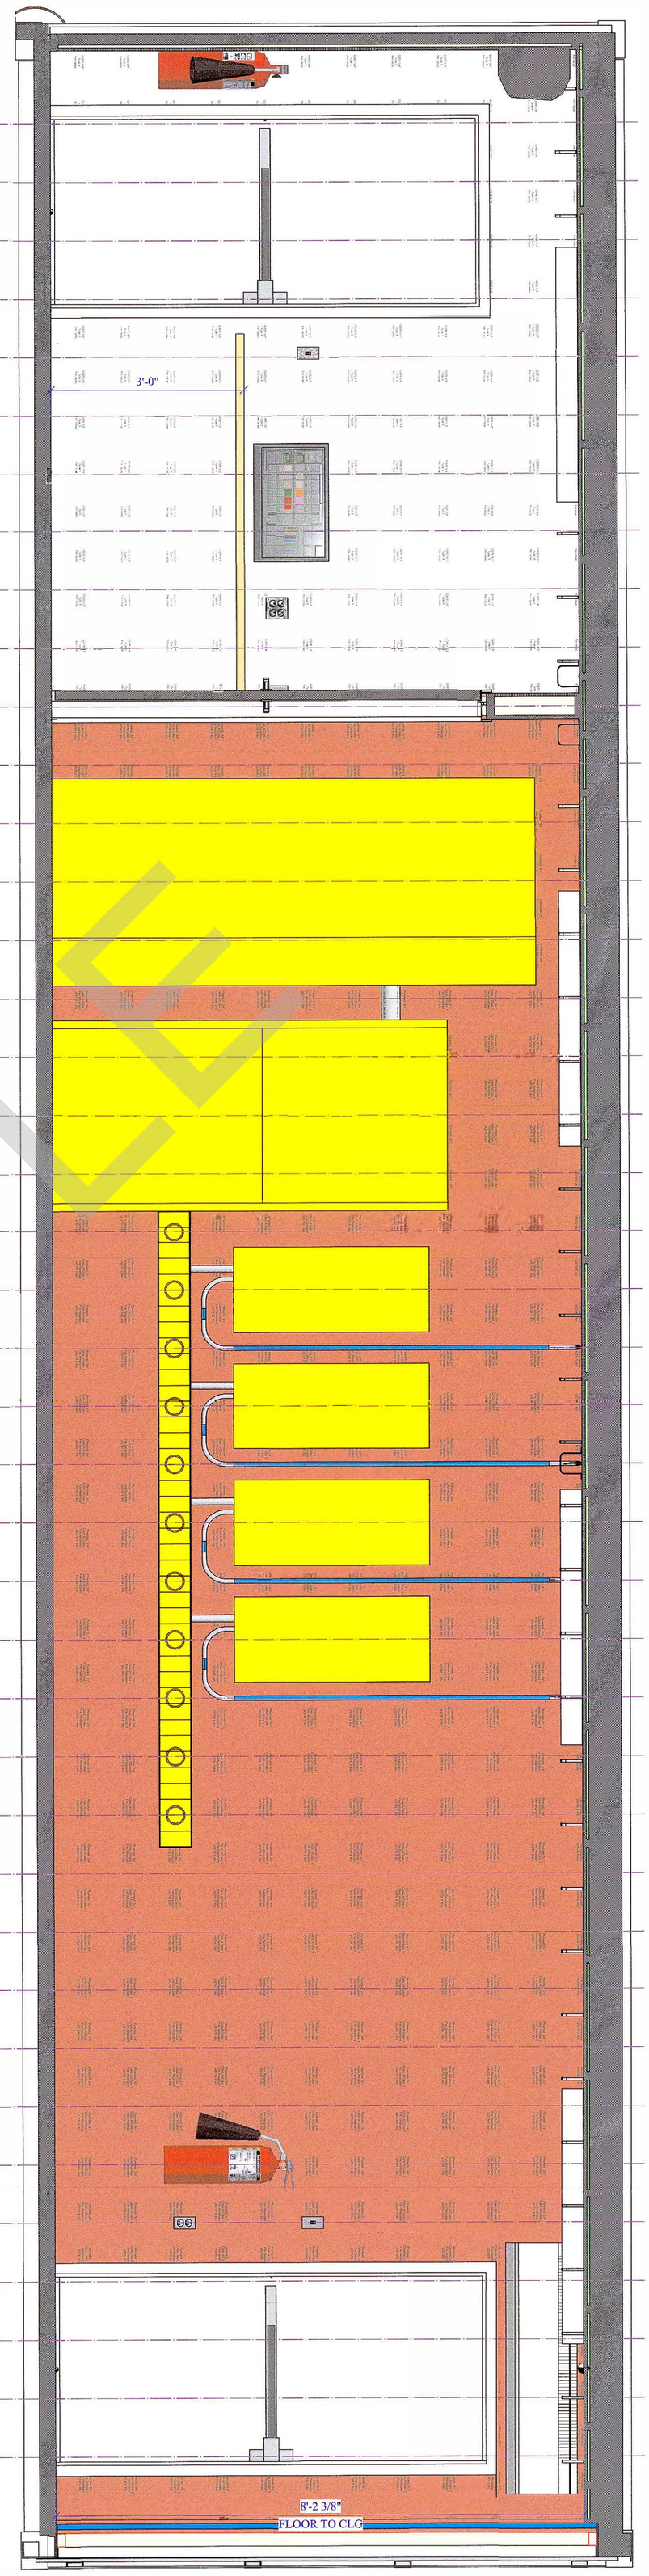

SAMPLE

Drawing No. Con40Hi-15 — of — Total Sheets	Project Title: CITY OF PHOENIX 27th AVE TRANSFER STATION	Design Firm: GREEN MOUNTAIN TECHNOLOGIES 5350 McDonald Ave NE Bainbridge Island WA 98110	Designed By: JPG & MBB	Date: 2016.11.03	PROGRESS PRINT
Scale: Sheet Scale	Drawing Title: PLAN & WEST INTERIOR ELEVATION	Consultant: - - -	Drawn By: MTW	Revision: Revision	Date: 2016, Dec 13
			Checked By: MBB	Project ID: -	Time: 3:17:30 PM
			Reviewed By: MBB	Drawing Code: Drawing Code	File name: CoP TAP 40ft Container.vwx
			Submitted By: GMT	CAD File Name: CoP ASP.vwx	
			Project Manager: -	Plot Date: 00/00/00	No.


Green Mountain Technologies
Commercial Composting Solutions

PROPRIETARY INFORMATION: THIS DRAWING IS THE PROPERTY OF GREEN MOUNTAIN TECHNOLOGIES & SHALL NOT BE USED, COPIED OR REPRODUCED IN WHOLE OR IN PART, NOR SHALL THE CONTENTS BE REVEALED IN ANY MANNER TO ANYONE UNLESS WRITTEN PERMISSION IS OBTAINED FROM GREEN MOUNTAIN TECHNOLOGIES.


A1 PLAN
Scale: 3/4" = 1'-0"




G1 INTERIOR ELEVATION LOOKING SOUTH
Scale: 3/4" = 1'-0"

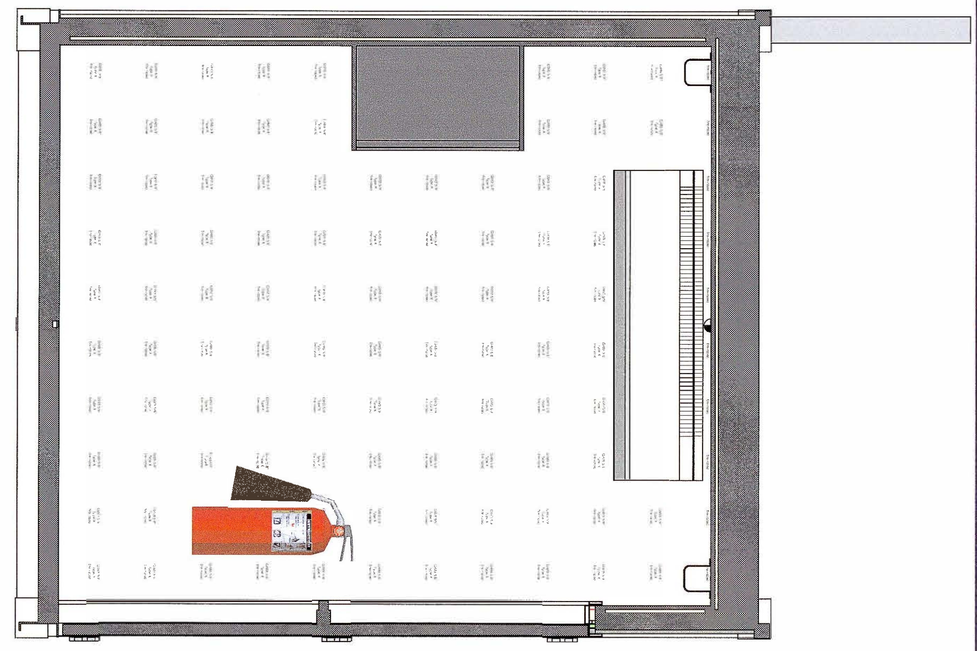


G5 INTERIOR ELEVATION LOOKING NORTH
Scale: 3/4" = 1'-0"

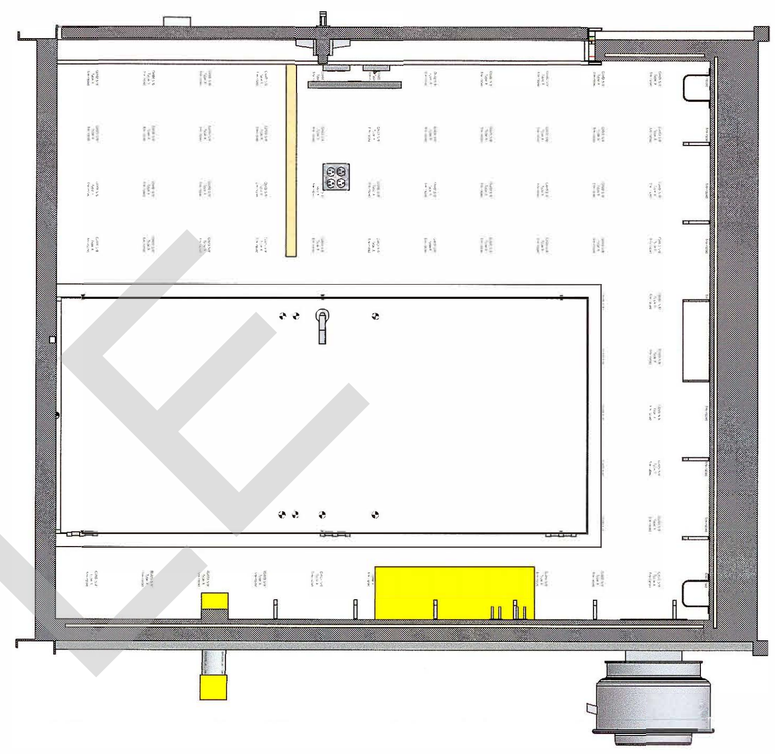

G9 INTERIOR ELEVATION LOOKING SOUTH
Scale: 3/4" = 1'-0"

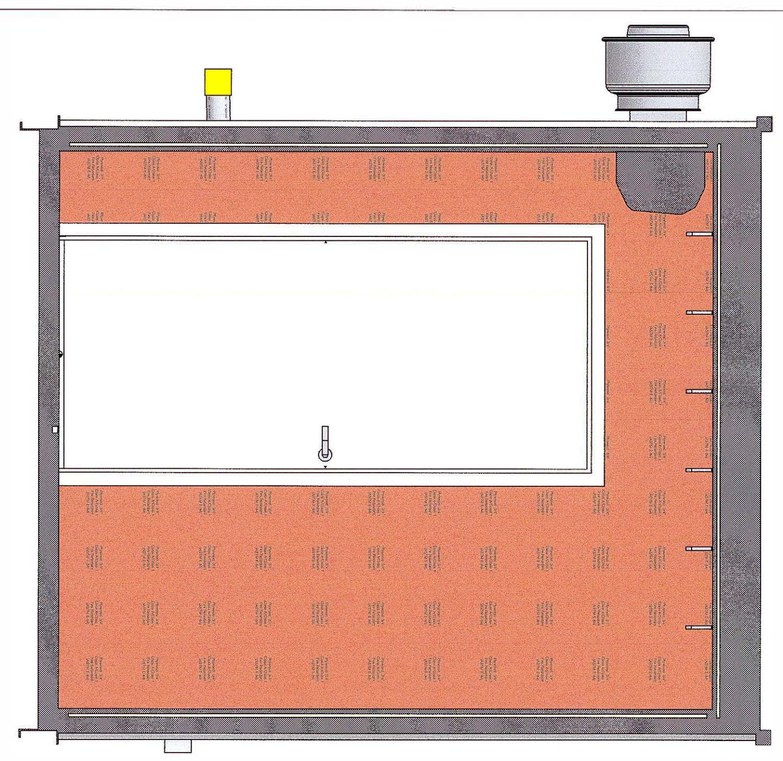

G13 INTERIOR ELEVATION LOOKING NORTH
Scale: 3/4" = 1'-0"

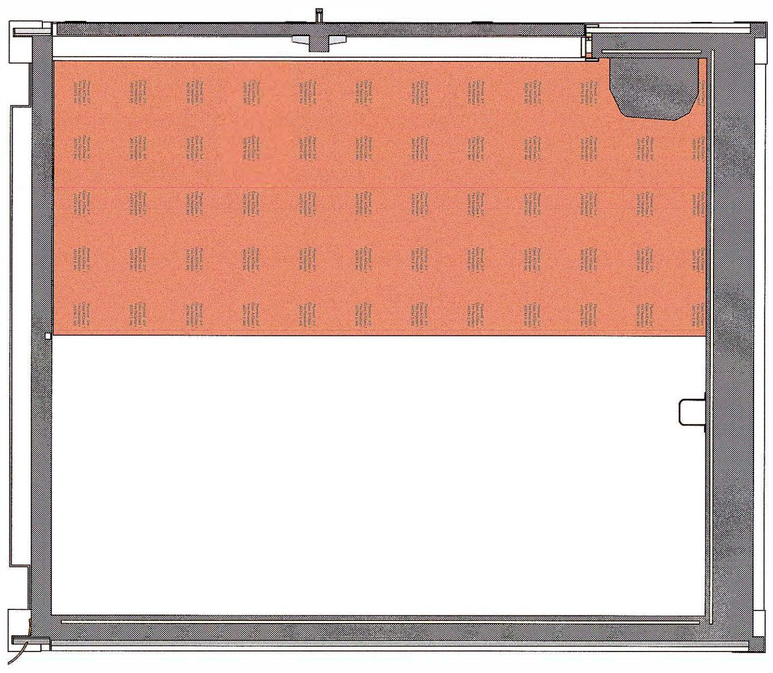

SAMPLE

Drawing No. Con40Hi-17 — of — Total Sheets	Project Title: CITY OF PHOENIX 27th AVE TRANSFER STATION	Design Firm: GREEN MOUNTAIN TECHNOLOGIES 5350 McDonald Ave NE Bainbridge Island WA 98110	Designed By: JPG & MBB	Date: 2016.11.03	PROGRESS PRINT
Scale: Sheet Scale	Drawing Title: PLAN & WEST INTERIOR ELEVATION	Consultant: - - -	Drawn By: MTW	Revision: Revision	Date: 2016, Dec 13
			Checked By: MBB	Project ID: -	Time: 3:17:34 PM
			Reviewed By: MBB	Drawing Code: Drawing Code	File name: CoP TAP 40ft Container.vwx
			Submitted By: GMT	CAD File Name: CoP ASP.vwx	
			Project Manager: -	Plot Date: 00/00/00	No.

Green Mountain Technologies
Commercial Composting Solutions

PROPRIETARY INFORMATION: THIS DRAWING IS THE PROPERTY OF GREEN MOUNTAIN TECHNOLOGIES & SHALL NOT BE USED, COPIED OR REPRODUCED IN WHOLE OR IN PART, NOR SHALL THE CONTENTS BE REVEALED IN ANY MANNER TO ANYONE UNLESS WRITTEN PERMISSION IS OBTAINED FROM GREEN MOUNTAIN TECHNOLOGIES.